



57 Daniel Webster Hwy.  
Merrimack, NH

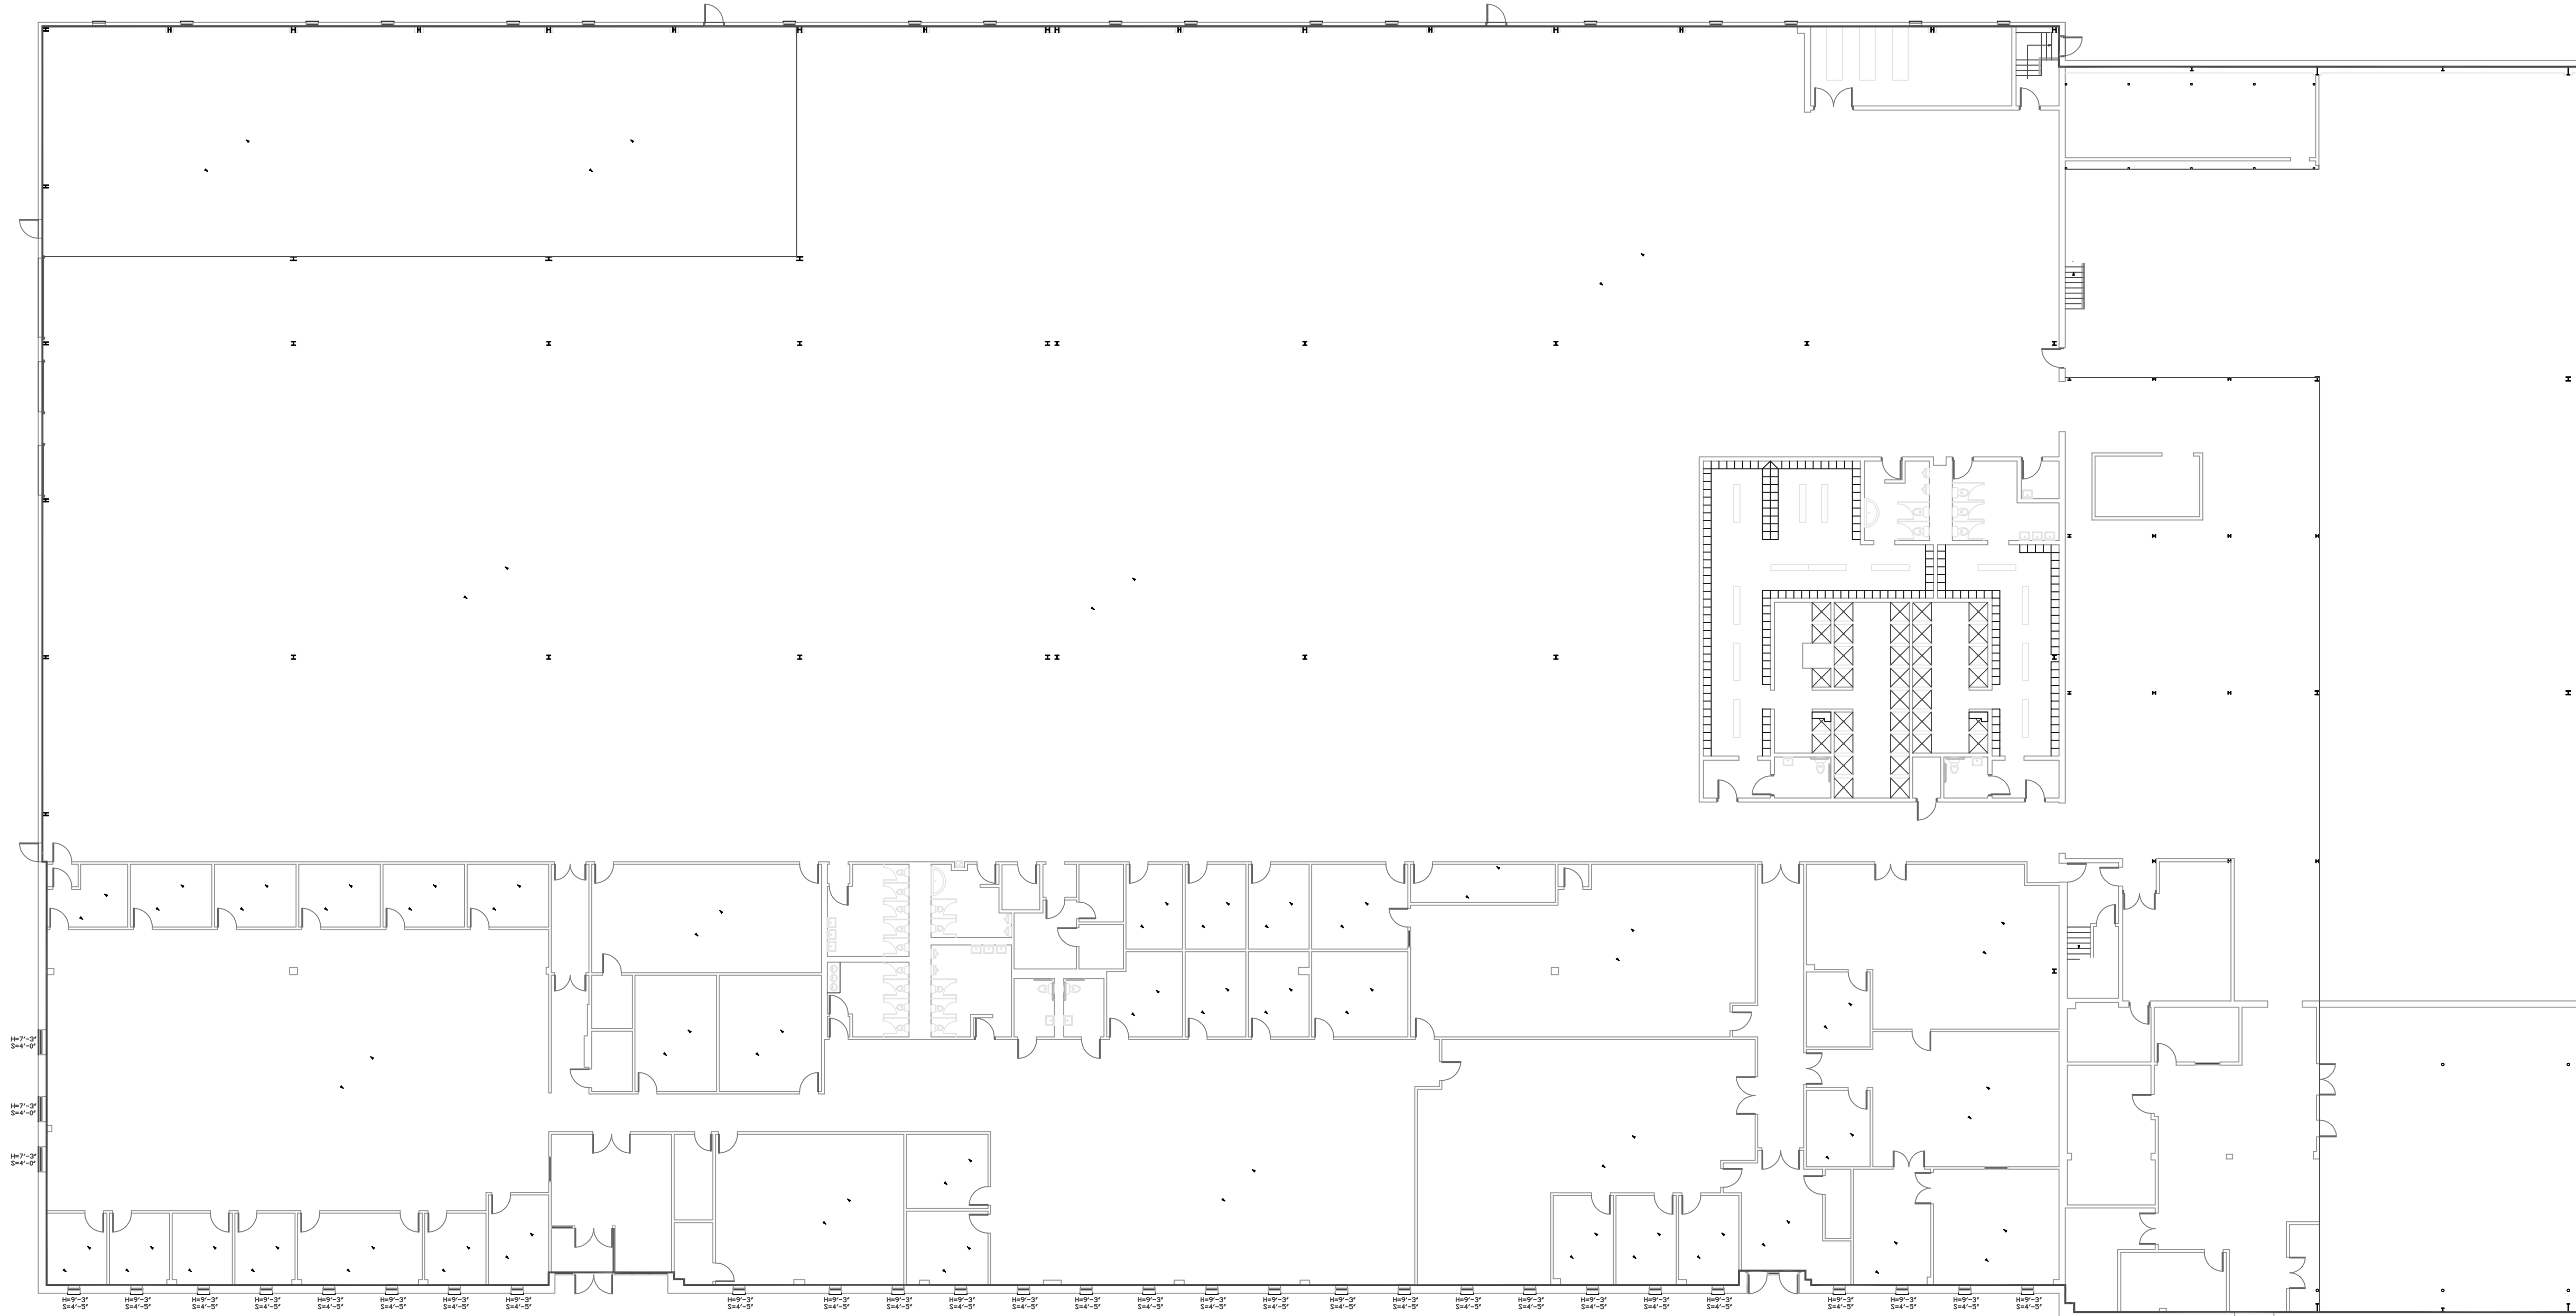

1 EXISTING FIRST FLOOR PLAN  
104,158 gross sq. ft.

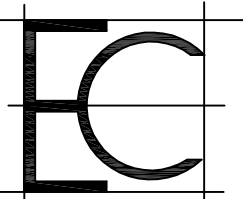

**Existing Conditions  
Surveys, Inc.**

398 Columbus Avenue #334  
Boston, MA 02116

Phone: 617-247-9161  
Fax: 617-249-0746  
Email: [info@existingconditions.com](mailto:info@existingconditions.com)

The Most Accurate  
Existing Conditions Surveys and  
As-Built Surveys  
[www.existingconditions.com](http://www.existingconditions.com)

No.	Revision/Issue	Date
-----	----------------	------

Existing Conditions  
Floor Plans  
First Floor  
Part A

Scale: 1/16"=1'-0"

Date: 2/24/2009

Drawn By: JES

**EX-1**