

SUITE 600
18,411 RSF

AS-BUILT
DIAGRAM

101 W PONCE DE LEON AVENUE
DECATUR, GA 30030


For leasing information, contact:

JESSICA DOYLE
Senior Vice President
+1 404 408 1264
jessica.doyle@cbre.com

GRAHAM LITTLE
First Vice President
+1 404 771 7957
graham.little@cbre.com

CBRE, INC.
+1 404 504 7900
cbre.com/atlanta

101
W. PONCE

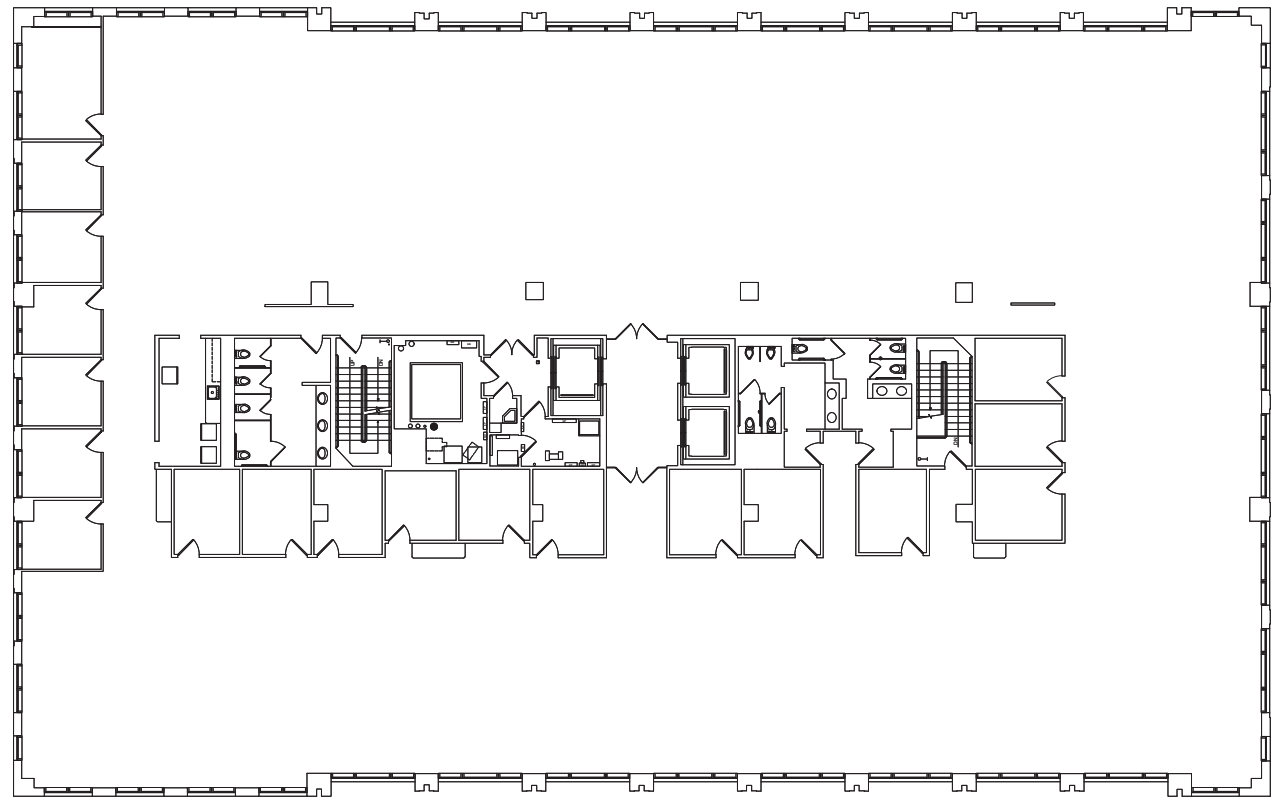

RMR
OFFICE

CBRE