

**SUITE 350**  
**10,788 RSF**

**AS-BUILT**  
**DIAGRAM**



**101 W PONCE DE LEON AVENUE**  
**DECATUR, GA 30030**

For leasing information, contact:

**JESSICA DOYLE**  
Senior Vice President  
+1 404 408 1264  
jessica.doyle@cbre.com

**GRAHAM LITTLE**  
Vice President  
+1 404 771 7957  
graham.little@cbre.com

**CBRE, INC.**  
+1 404 504 7900  
cbre.com/atlanta

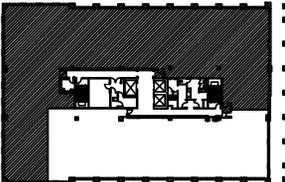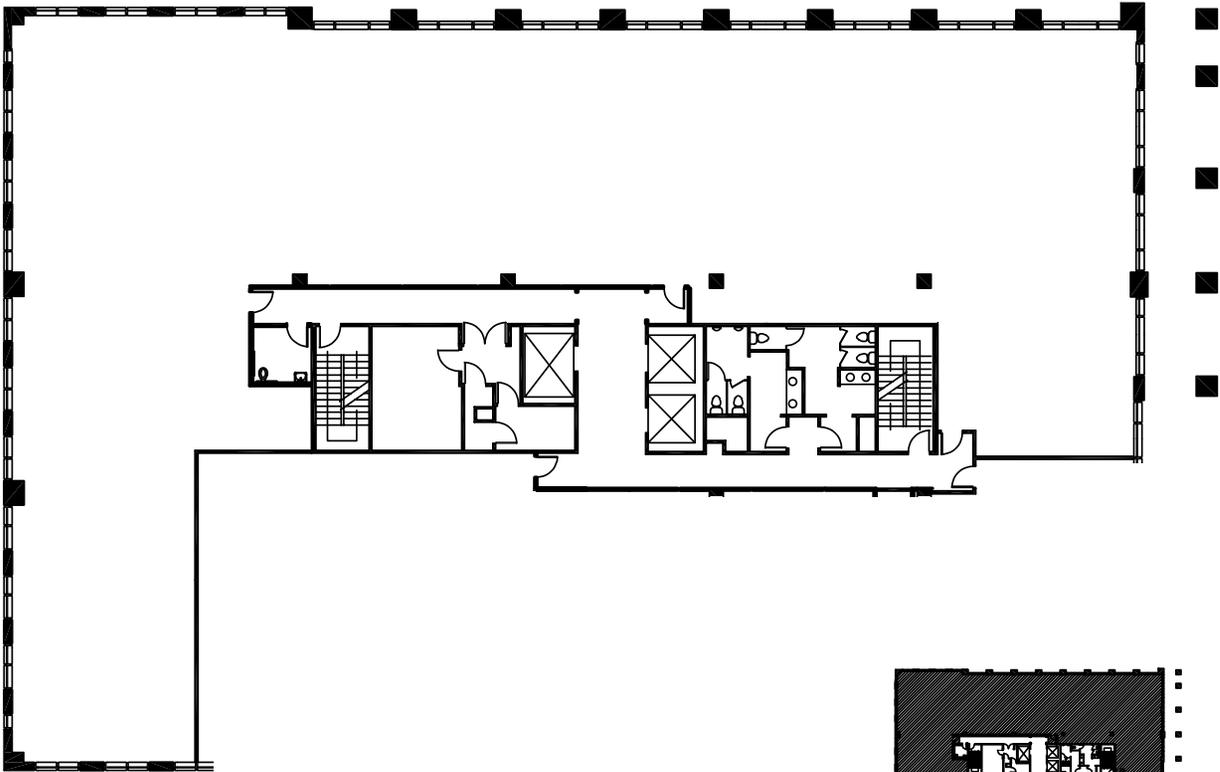

Key Plan