

SUITE 350

10,788 RSF

AS-BUILT DIAGRAM

101 W PONCE DE LEON AVENUE
DECATUR, GA 30030

For leasing information, contact:

JESSICA DOYLE
Senior Vice President
+1 404 408 1264
jessica.doyle@cbre.com



GRAHAM LITTLE
First Vice President
+1 404 771 7957
graham.little@cbre.com

CBRE, INC.
+1 404 504 7900
cbre.com/atlanta



101

W. PONCE

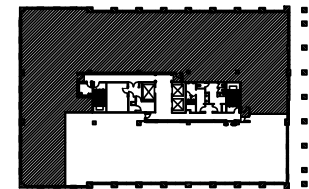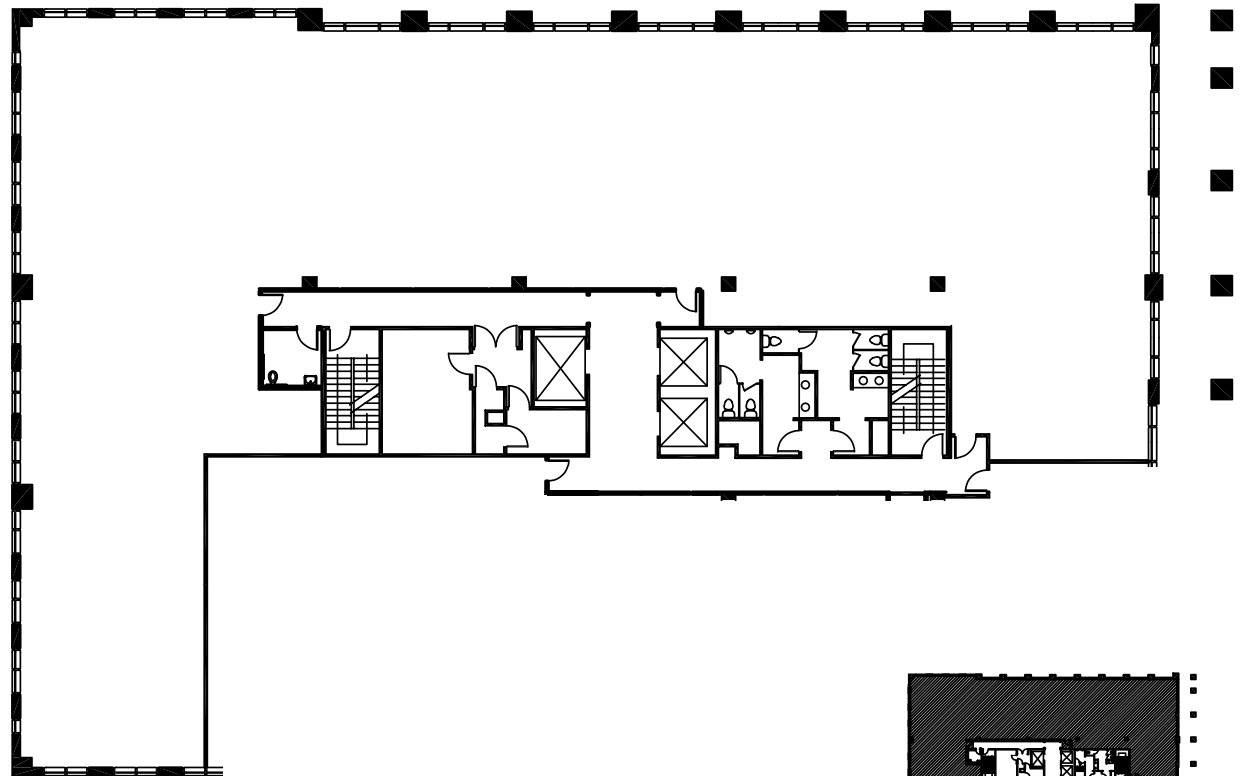

Key Plan