



suite floor plan

current as-built plan

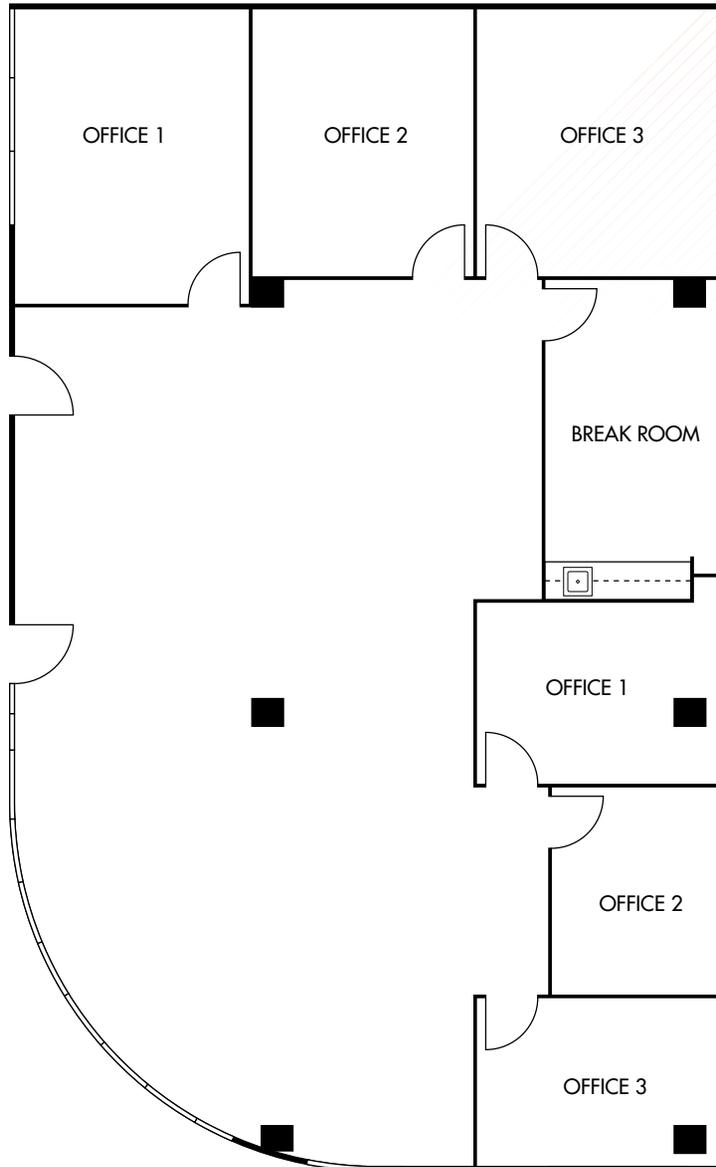

conceptual demise plan

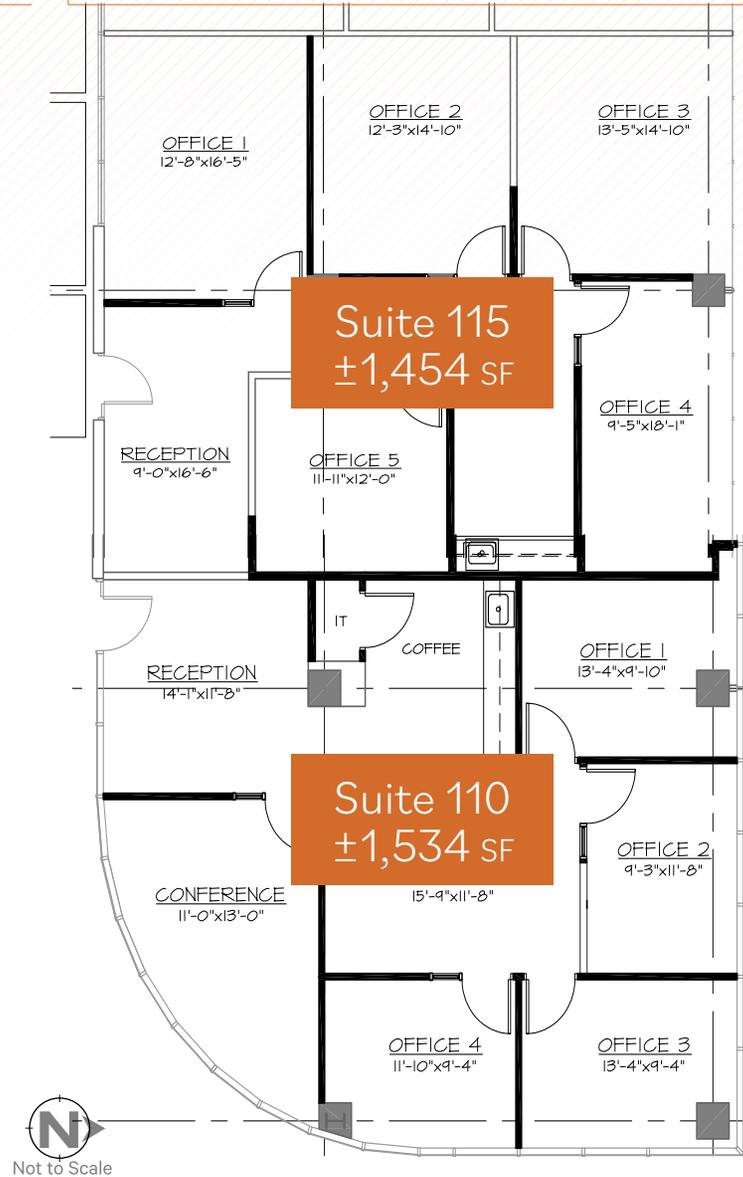

Suite
110-115

±2,988 SF

Lease Rate
\$20.50/SF
Full Service

OFFICE FOR LEASE