

SUITE: 140



RSF: 1,142

AS-BUILT CONFIGURATION

- OFFICES..... N/A
- RECEPTION..... N/A
- CONFERENCE..... N/A
- PANTRY..... N/A
- OPEN WORK AREA..... N/A

KEY PLAN

Not to scale, furniture and appliances not included

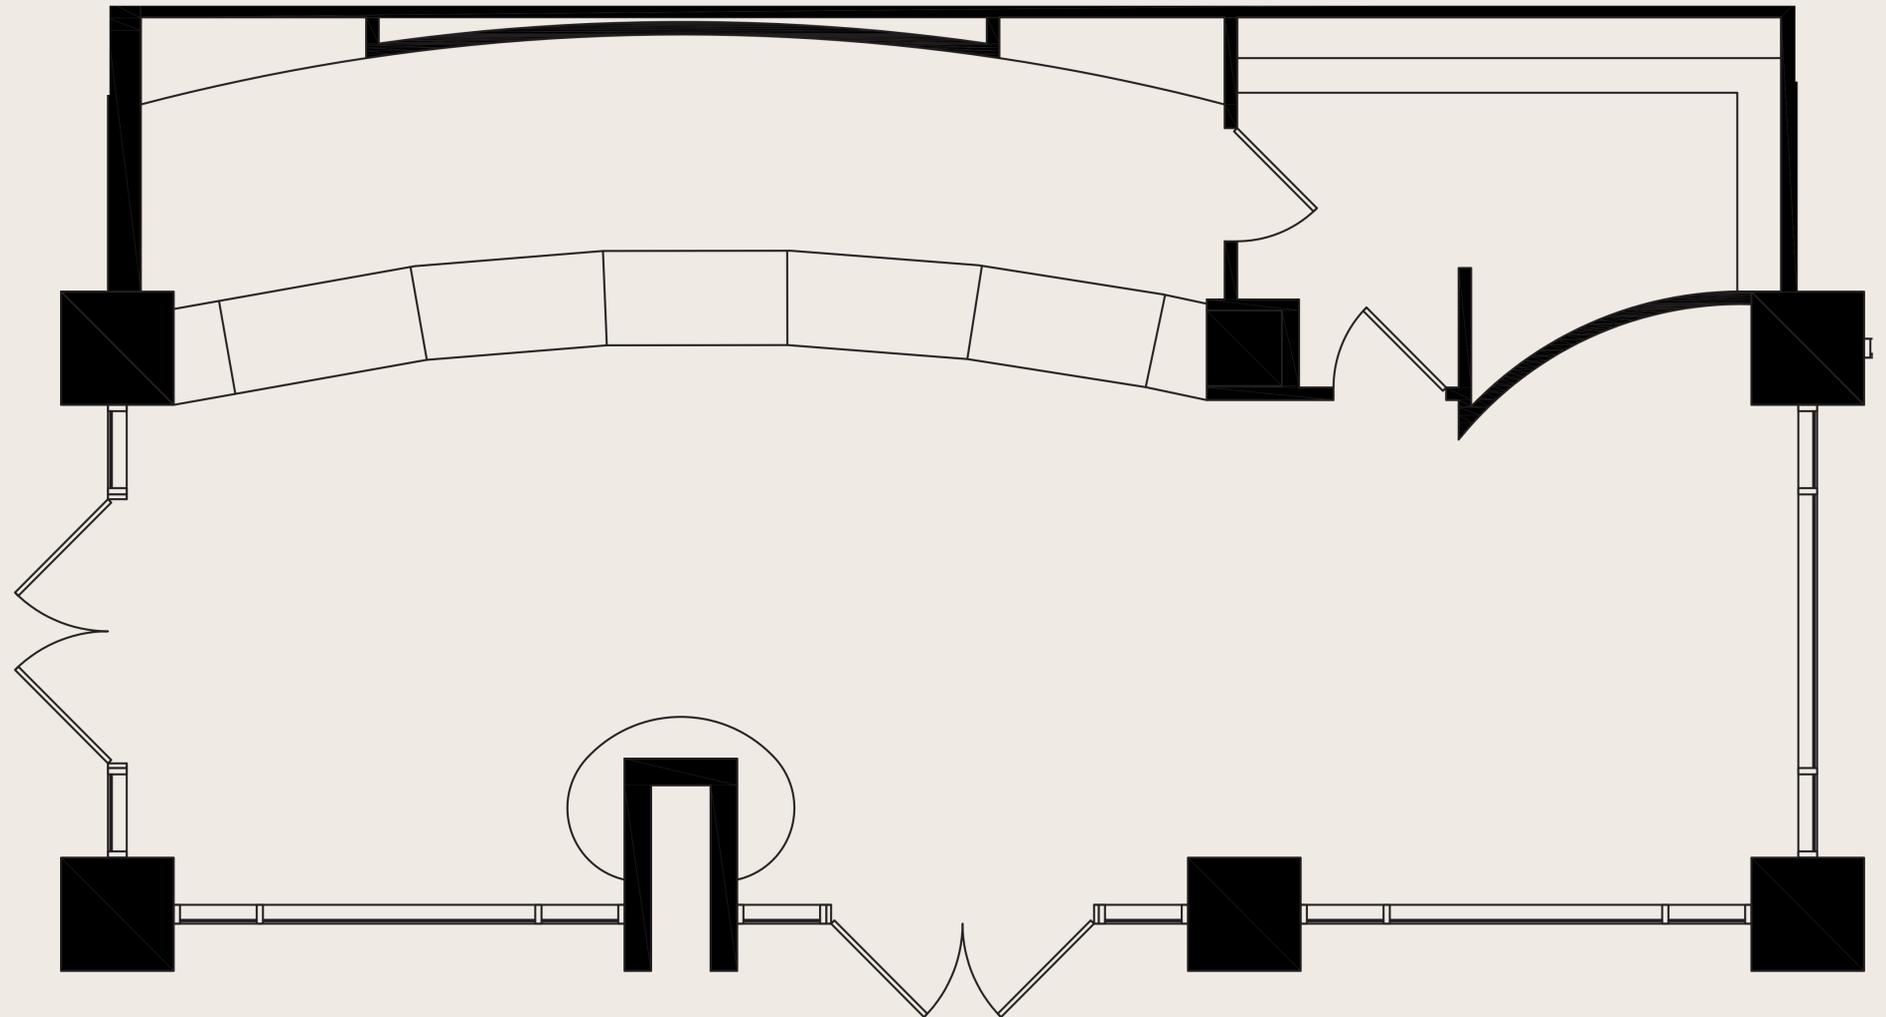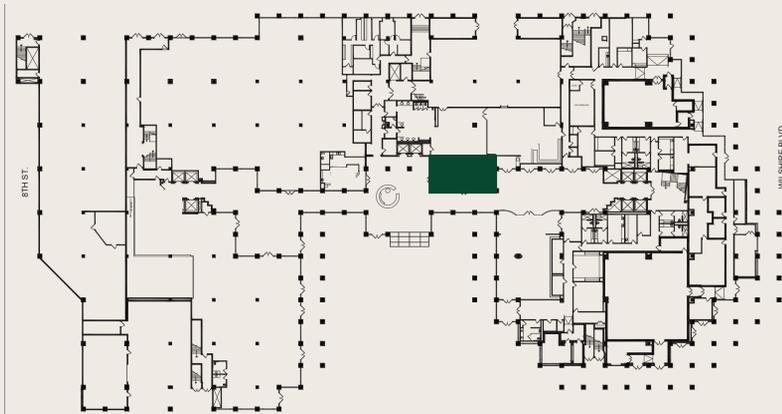

For leasing information, please contact:
USALEASING@ONNI.COM
(213) 629-2041