
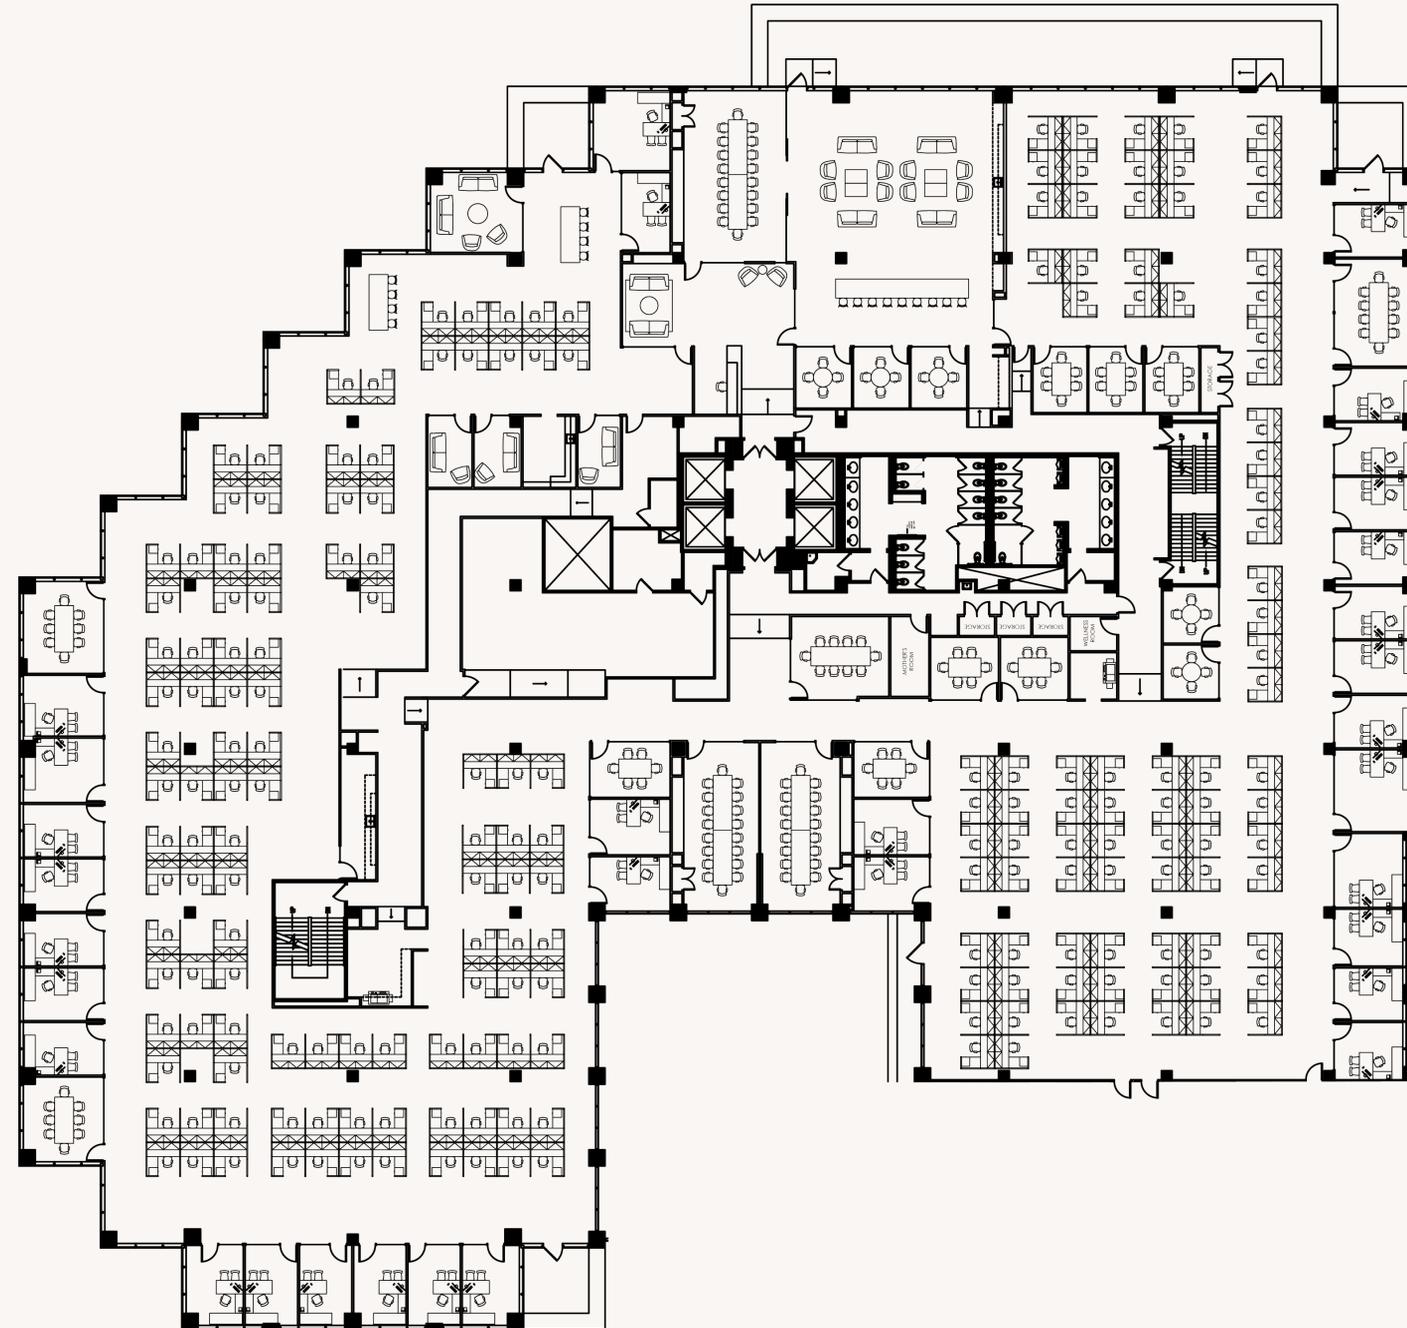


AS-BUILT CONFIGURATION

Offices.....	32
Reception	1
Conference/Huddle.....	22
Kitchen/Pantry	2
Open Work Area	+/- 192

KEY PLAN

Not to scale, furniture and appliances not included

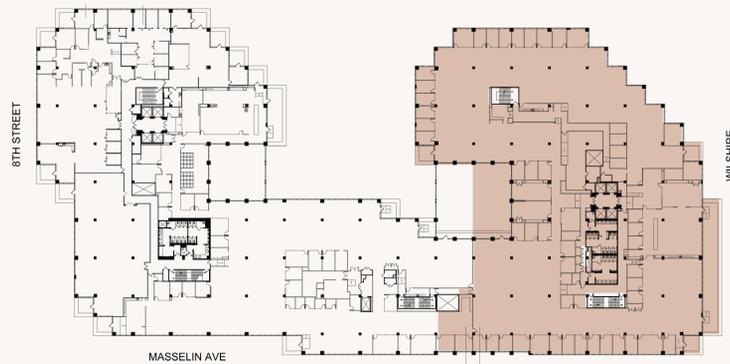

John Zanetos
Executive Vice President
+1 213 613 3704
john.zanetos@cbre.com

Chris Penrose
Senior Vice President
+1 213 613 3108
chris.penrose@cbre.com

Patrick Amos
Senior Vice President
+1 310 903 6904
patrick.amos@cbre.com

Kelli Snyder
Senior Associate
+1 213 613 3308
kelli.snyder@cbre.com

Dylan Hanseth
Senior Associate
+1 805 637 5455
dylan.hanseth@cbre.com

Todd Doney
Vice Chairman
+1 213 593 1360
todd.doney@cbre.com