
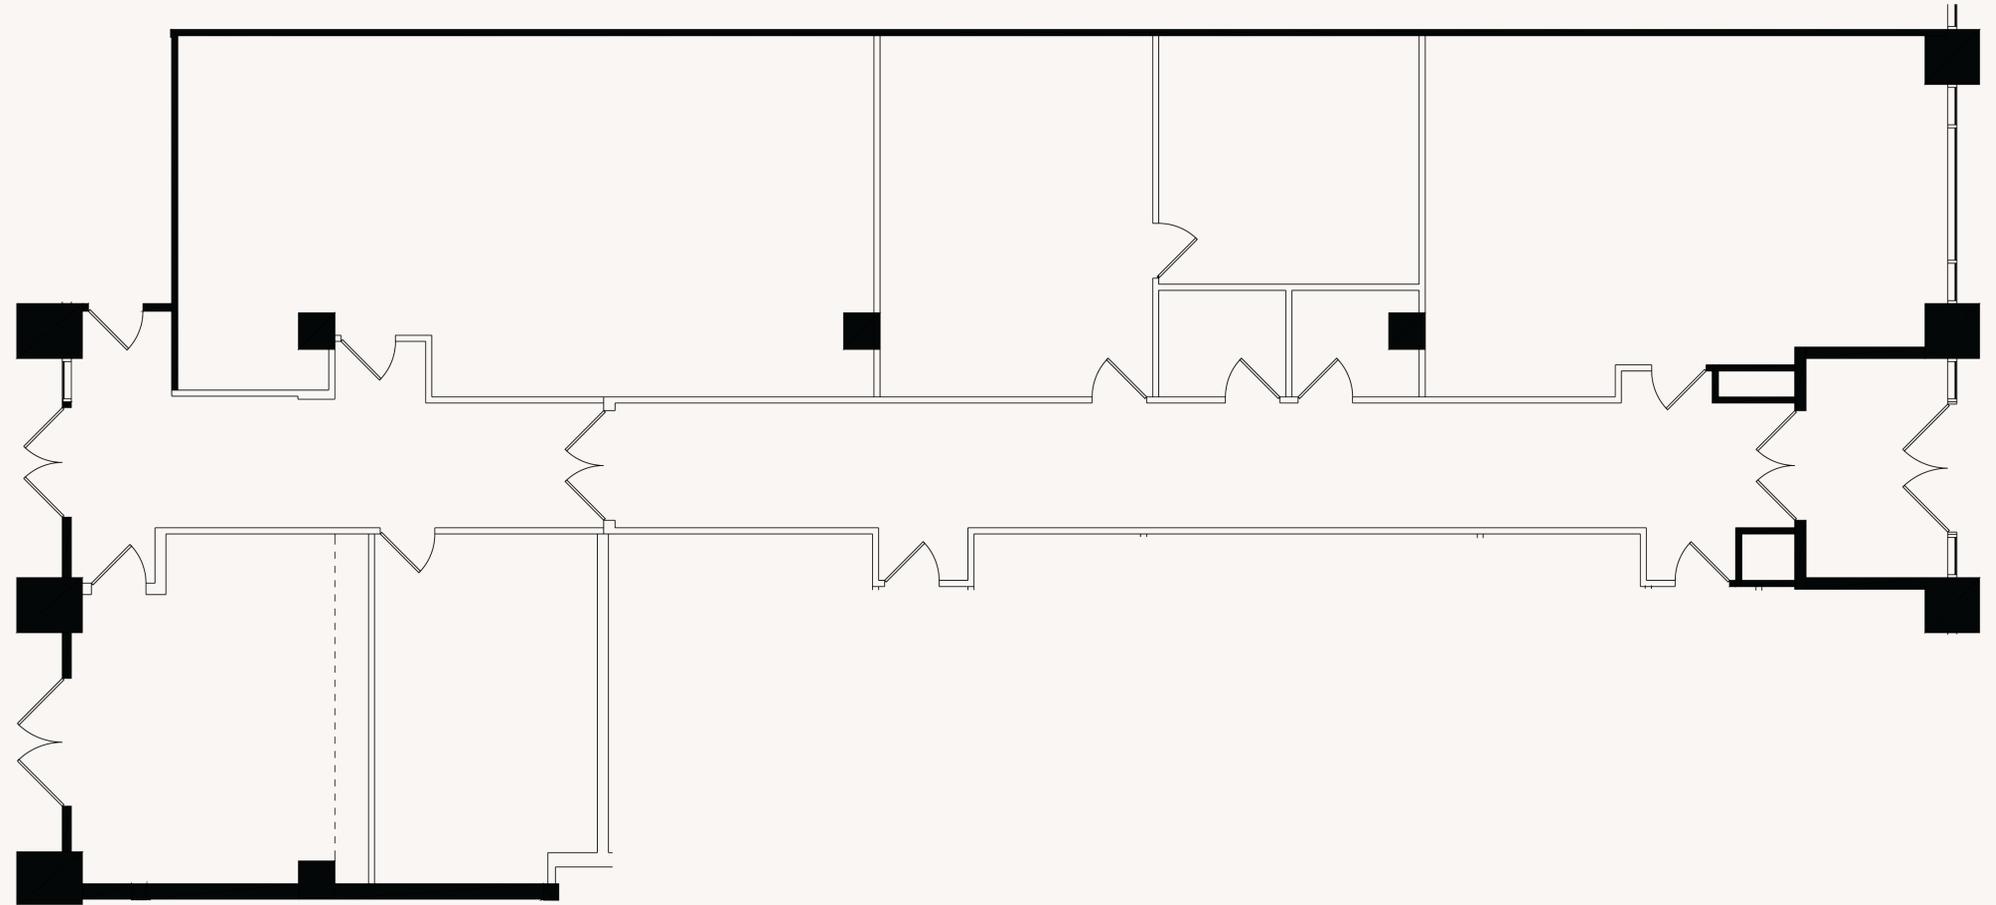


### AS-BUILT CONFIGURATION

- Offices..... N/A
- Reception ..... N/A
- Conference/Huddle..... N/A
- Kitchen/Pantry ..... N/A
- Open Work Area ..... N/A

### KEY PLAN

*Not to scale, furniture and appliances not included*

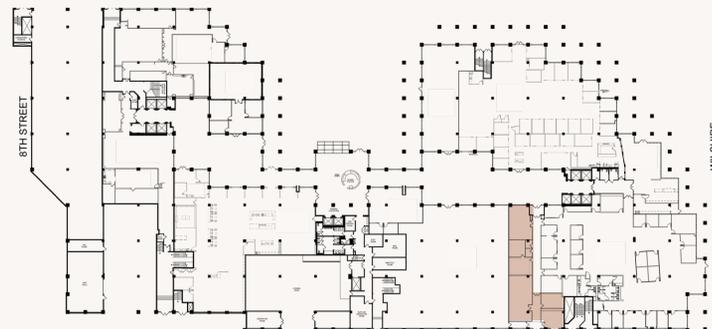

**John Zanetos**  
Executive Vice President  
+1 213 613 3704  
john.zanetos@cbre.com

**Chris Penrose**  
Senior Vice President  
+1 213 613 3108  
chris.penrose@cbre.com

**Patrick Amos**  
Senior Vice President  
+1 310 903 6904  
patrick.amos@cbre.com

**Kelli Snyder**  
Senior Associate  
+1 213 613 3308  
kelli.snyder@cbre.com

**Dylan Hanseth**  
Senior Associate  
+1 805 637 5455  
dylan.hanseth@cbre.com

**Todd Doney**  
Vice Chairman  
+1 213 593 1360  
todd.doney@cbre.com