


**AS BUILT FLOOR PLAN** (FLOOR: 9)

SCALE: 1/4" = 1'-0"

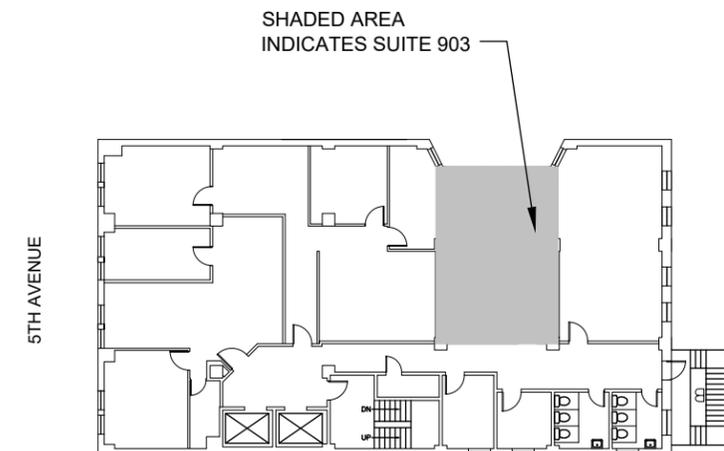

**KEY PLAN**

SCALE: NTS



**BLDG Management Co., Inc.**  
 417 FIFTH AVENUE  
 4TH FLOOR  
 NEW YORK, NY  
 10016 USA  
 TEL: 212.624.4300  
 FAX: 212.624.7259

BUILDING  
**AS BUILT PLAN**  
 362 FIFTH AVE, SUITE 903  
 NEW YORK, NY

SCALE	AS NOTED
DRAWN BY	SM
DATE	04.14.2021

**DISCLAIMER:**  
 THIS DOCUMENT HAS BEEN PREPARED AND MAINTAINED BY BLDG MANAGEMENT CO., INC. AND ITS AFFILIATE MANAGERS AND OWNERS FOR INTERNAL PURPOSES ONLY. BLDG HAS GIVEN YOU THIS DOCUMENT FOR INFORMATIONAL PURPOSES ONLY AT NO COST TO YOU. BLDG MAKES NO REPRESENTATIONS AS TO THE ACCURACY OF ANY OF THE INFORMATION CONTAINED IN THE WITHIN SKETCH, NOTES, AND DESCRIPTIONS, AND DISCLAIMS ALL RESPONSIBILITY FOR ANY DISCREPANCIES BASED UPON A PHYSICAL EXAMINATION OF THE PREMISES OR OTHERWISE.

SKETCH

**AS BUILT**