


Floor 6

± 24,574 RSF

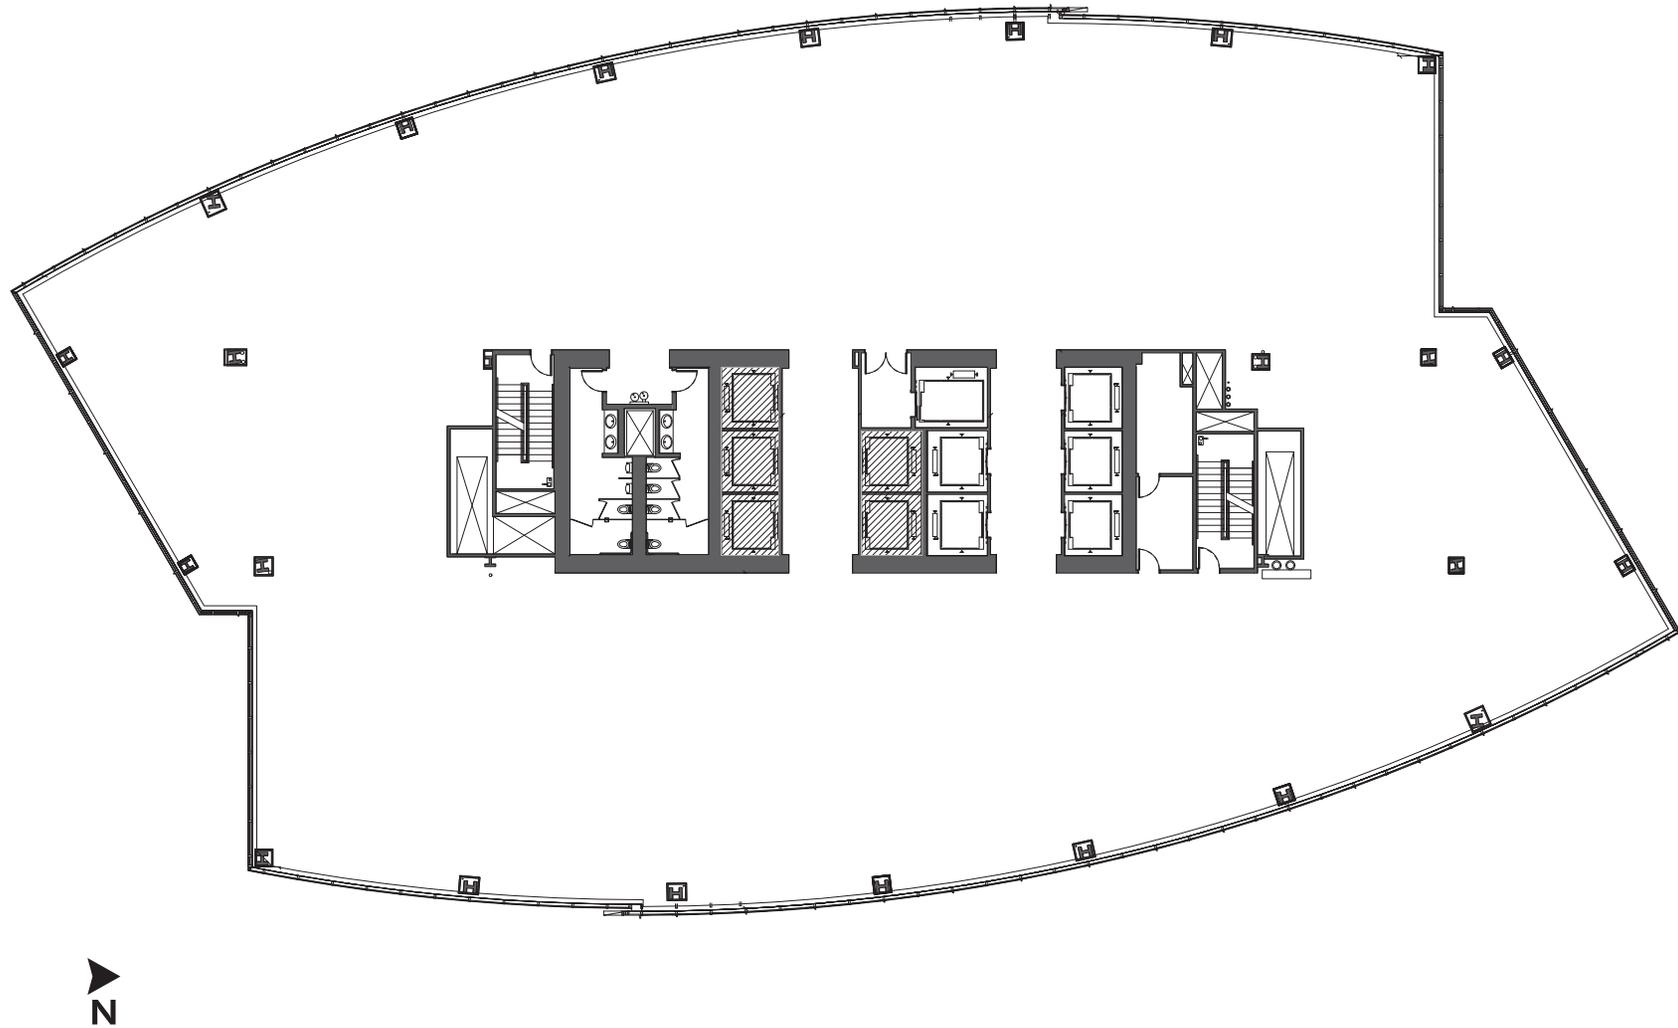

Floor 6

± 24,574 RSF

AS-BUILT PLAN

