



# Suite 500

28,279 SF

As-Built

**Sarajane Goodfellow**


303-628-7414

sarajane.goodfellow@cbre.com

**Allison Berry**

303-628-7456

allison.berry@cbre.com

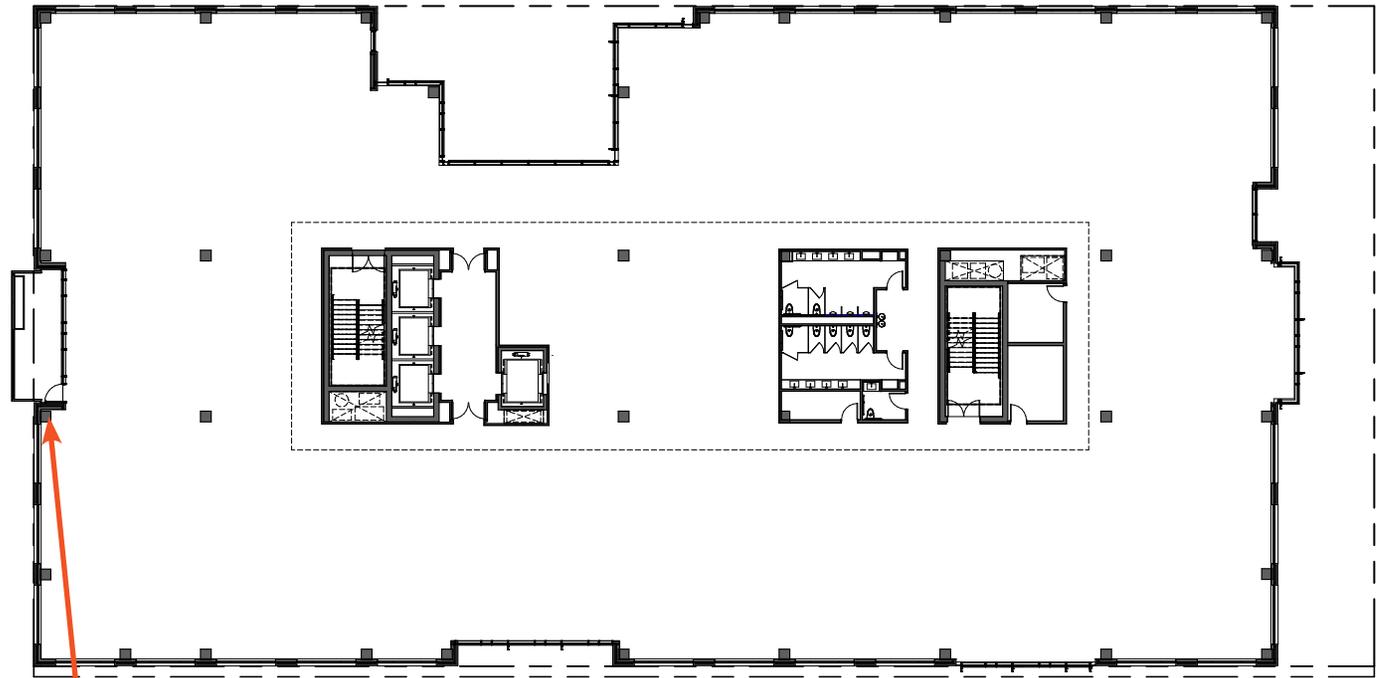

Private Balcony

3400 Walnut Street, Denver, CO 80205



Jordon Perlmutter & Co.

ROCKEFELLER  
GROUP