



Suite 400

28,304 SF

As-Built

Sarajane Goodfellow


303-628-7414

sarajane.goodfellow@cbre.com

Allison Berry

303-628-7456

allison.berry@cbre.com

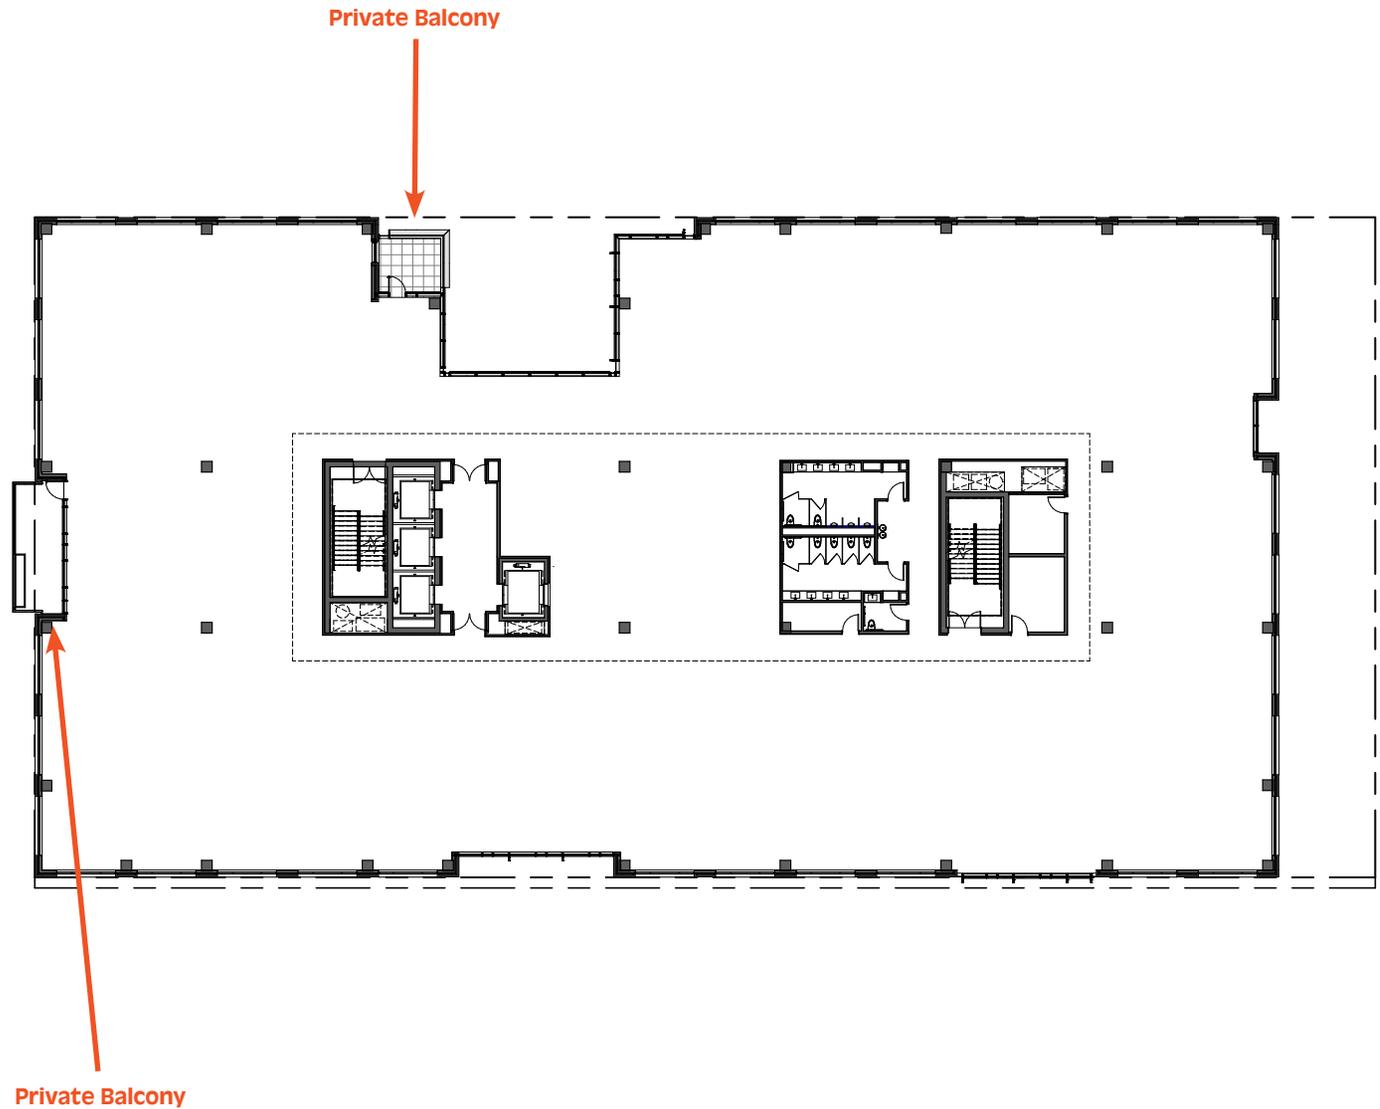

3400 Walnut Street, Denver, CO 80205



Jordon Perlmutter & Co.

ROCKEFELLER
GROUP