



SUITE 200

±4,000 SF

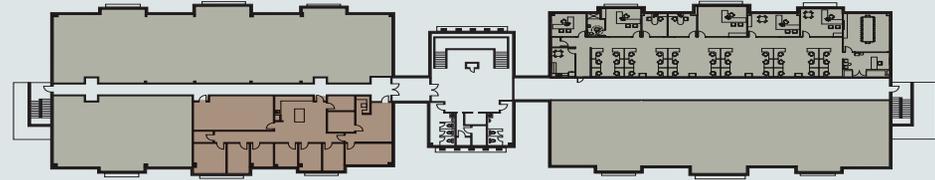

AS-BUILT LAYOUT

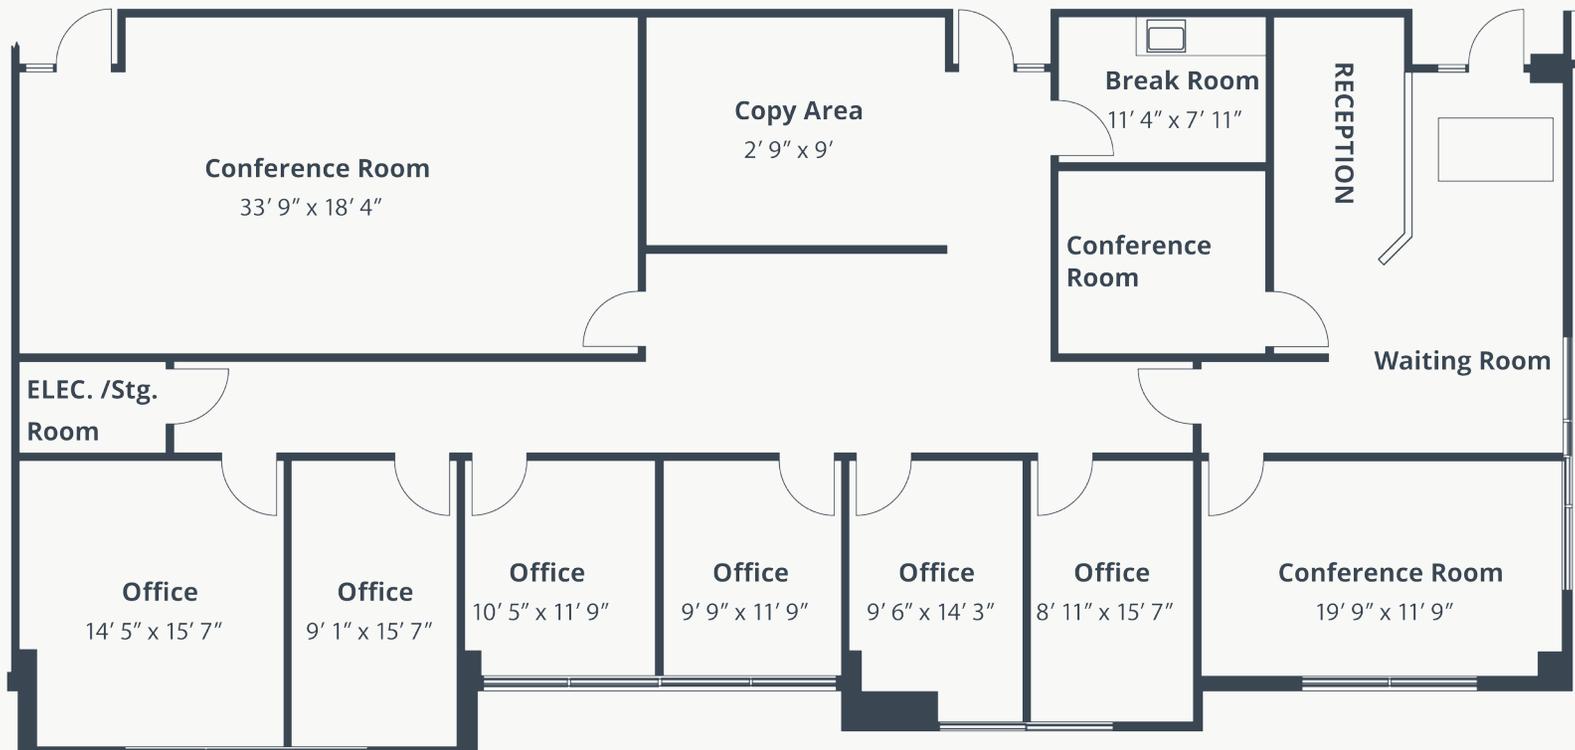

◀ N
NOT TO SCALE