

**SUITE
 200, 205**

THREE
 MEMORIAL
 2ND FLOOR


CBRE

11.16.2020

.....

AS-BUILT
 PLAN

AS.2

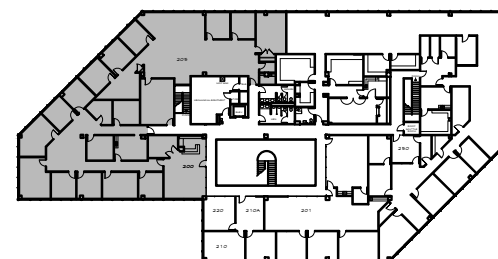

A FLOOR PLAN

SCALE: N.T.S.



NORTH

8483 RSF

B KEY PLAN

SCALE: N.T.S.



NORTH