





kinslow, keith & todd, inc.
architecture interiors engineering

tel 918.744.4270
fax 918.744.7849
2200 south utica place, suite 200
tulsa, oklahoma 74114
www.kktarchitects.com

SUITE 104
1,330.91 R.S.F.

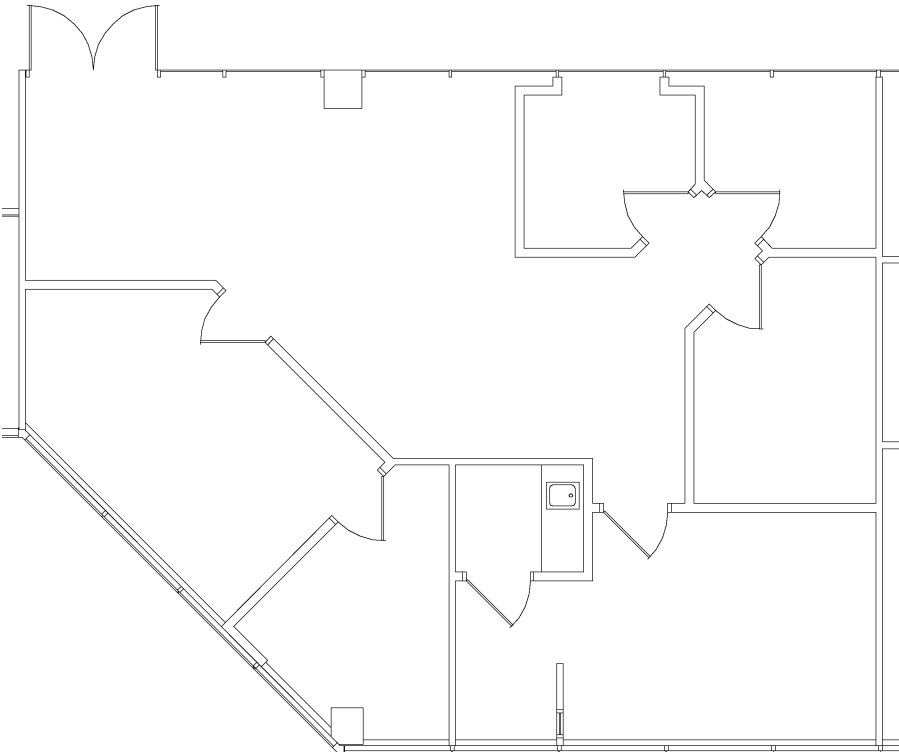

A FLOOR PLAN 
SCALE: N.T.S. NORTH

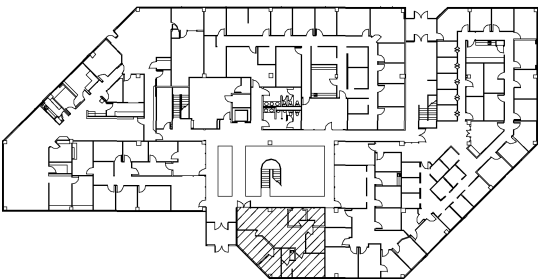

B FLOOR PLAN 
SCALE: N.T.S. NORTH

THREE
MEMORIAL

SUITE 104

SCALE	N.T.S.
FILE NAME	3M01AS
MANAGER	YW
DRAWN BY	TT
4/15/14	

ASBUILT
PLAN

AS-1