




id
insight
design

1900 N. Bayshore
Drive - #204-A
Miami, Florida
3 3 1 3 2
305.545.4964

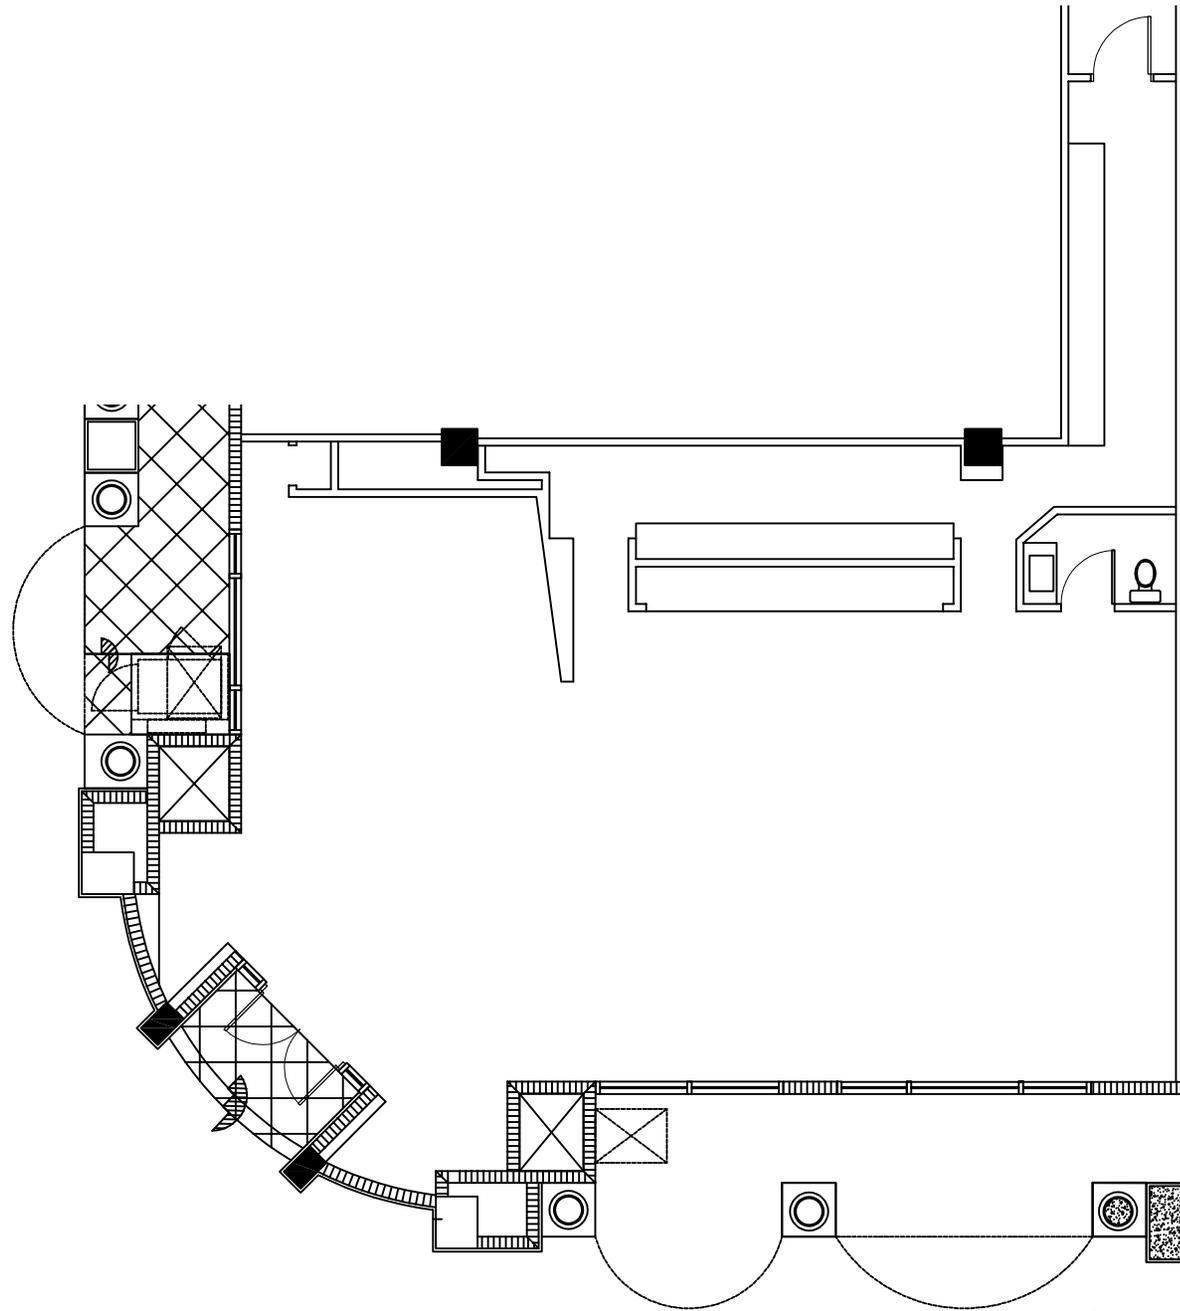

4000 Ponce De Leon

As Built Plan / Ground Floor

3/32"=1'-0"



PROJECT NO:	1806-00
DRAWN BY:	A.M.
DATE:	07/01/25
SCALE:	3/32"=1'-0"
SHEET NO:	SK-1