



Key Plan

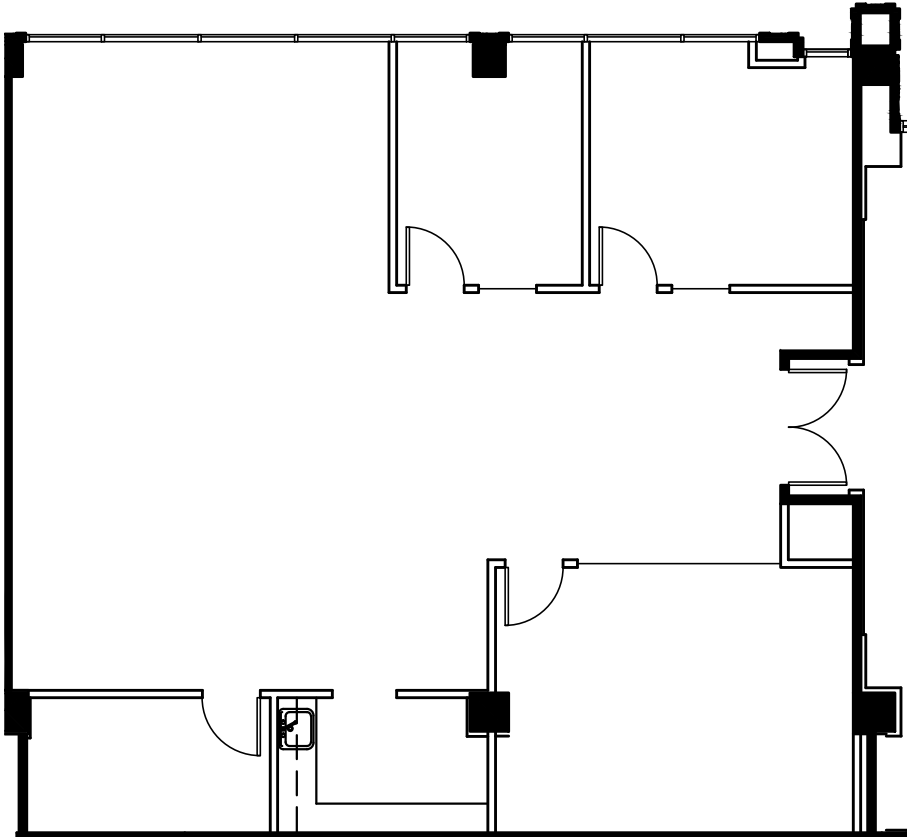

Plan North

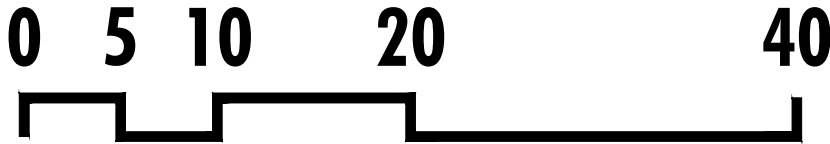

NELSON

Windward Fairways I • Suite 100 • 2,105 RSF

As Built