


Key Plan

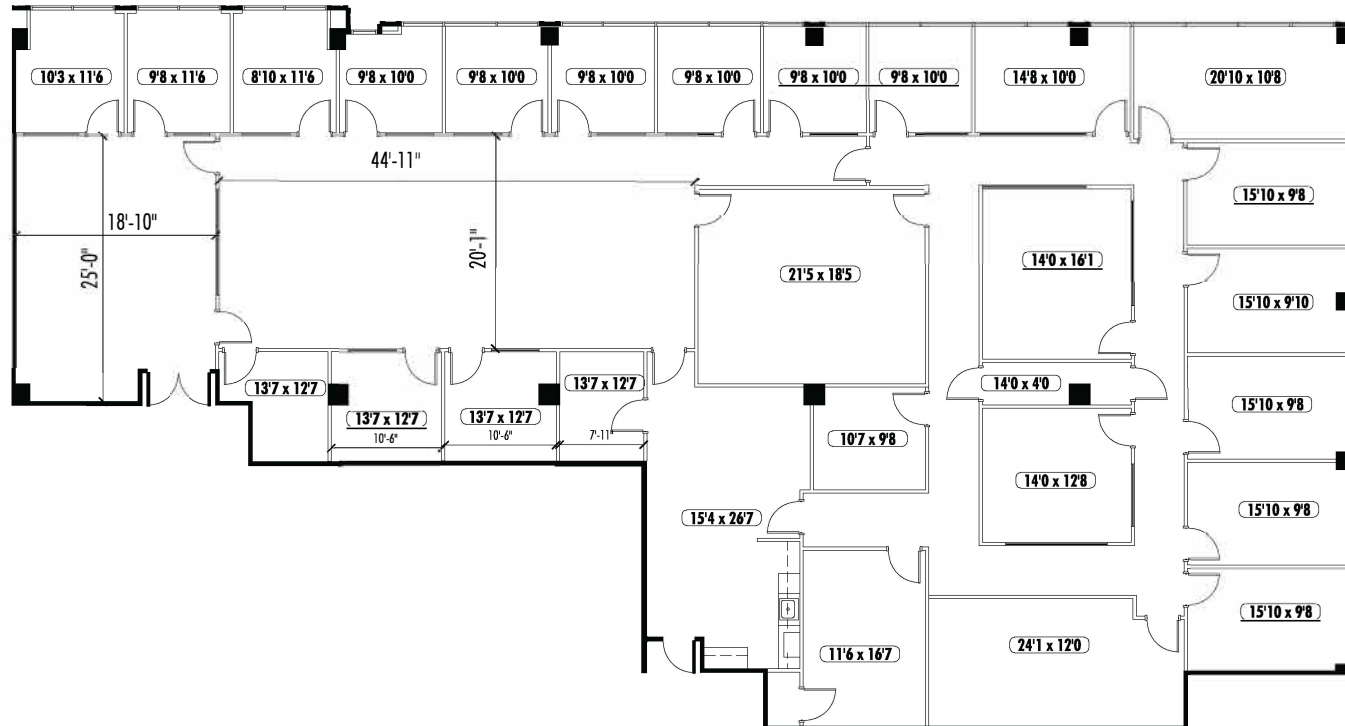

Plan North

Not to Scale

*This Suite has not been verified by NELSON and may not reflect changes made in the field.

CBRE

Stewart Thrash 678.322.6772
Eric Ross 404.229.7629

NELSON Windward Fairways I • Suite 250 • 7,890 RSF

As-Built