




FLAGSHIP


corporate center

Suite 100

As-Built 7,388 Sq. Ft.

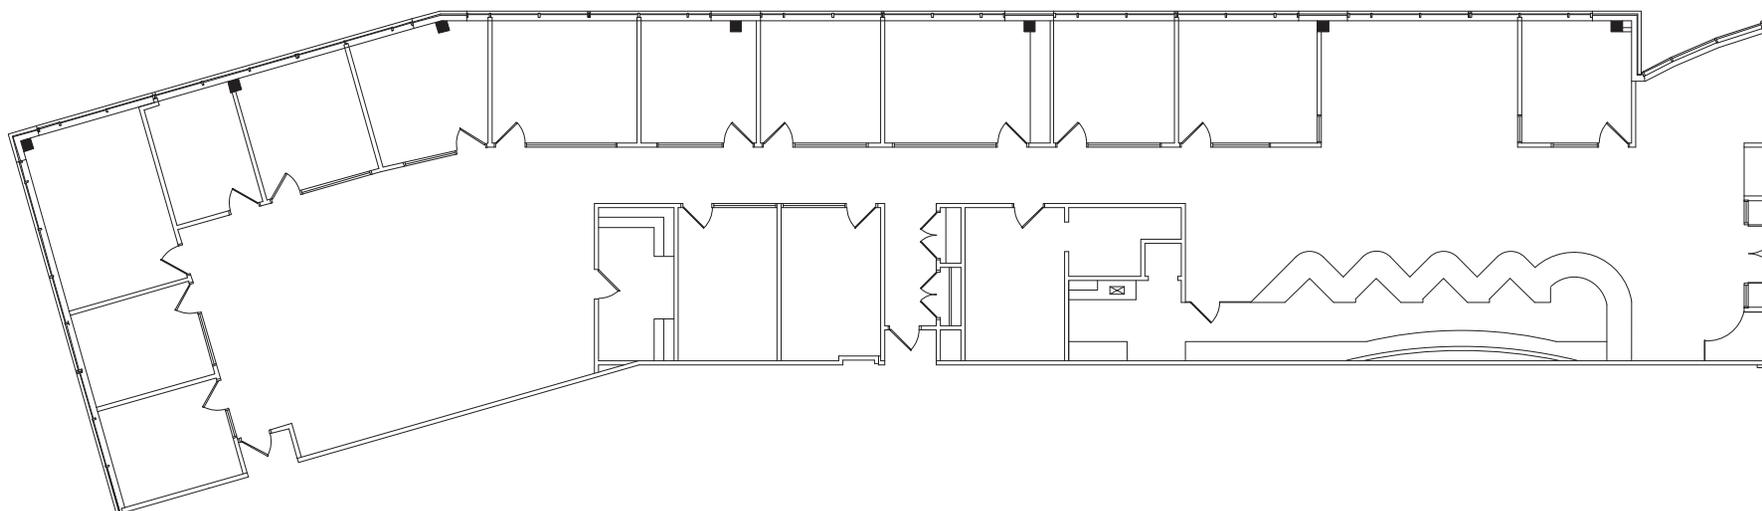

** Dimensions are Deemed
as Accurate but not to Scale*

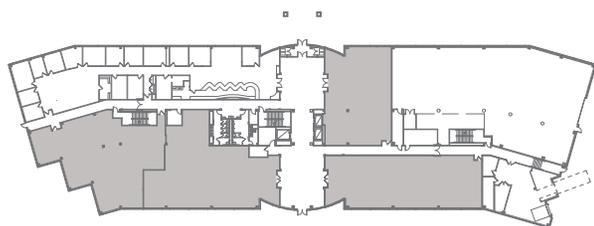

OWNED & MANAGED BY



LEASED BY

