


O N E D A G

FLOOR 25
ENTIRE
AS BUILT

16,121 RSF

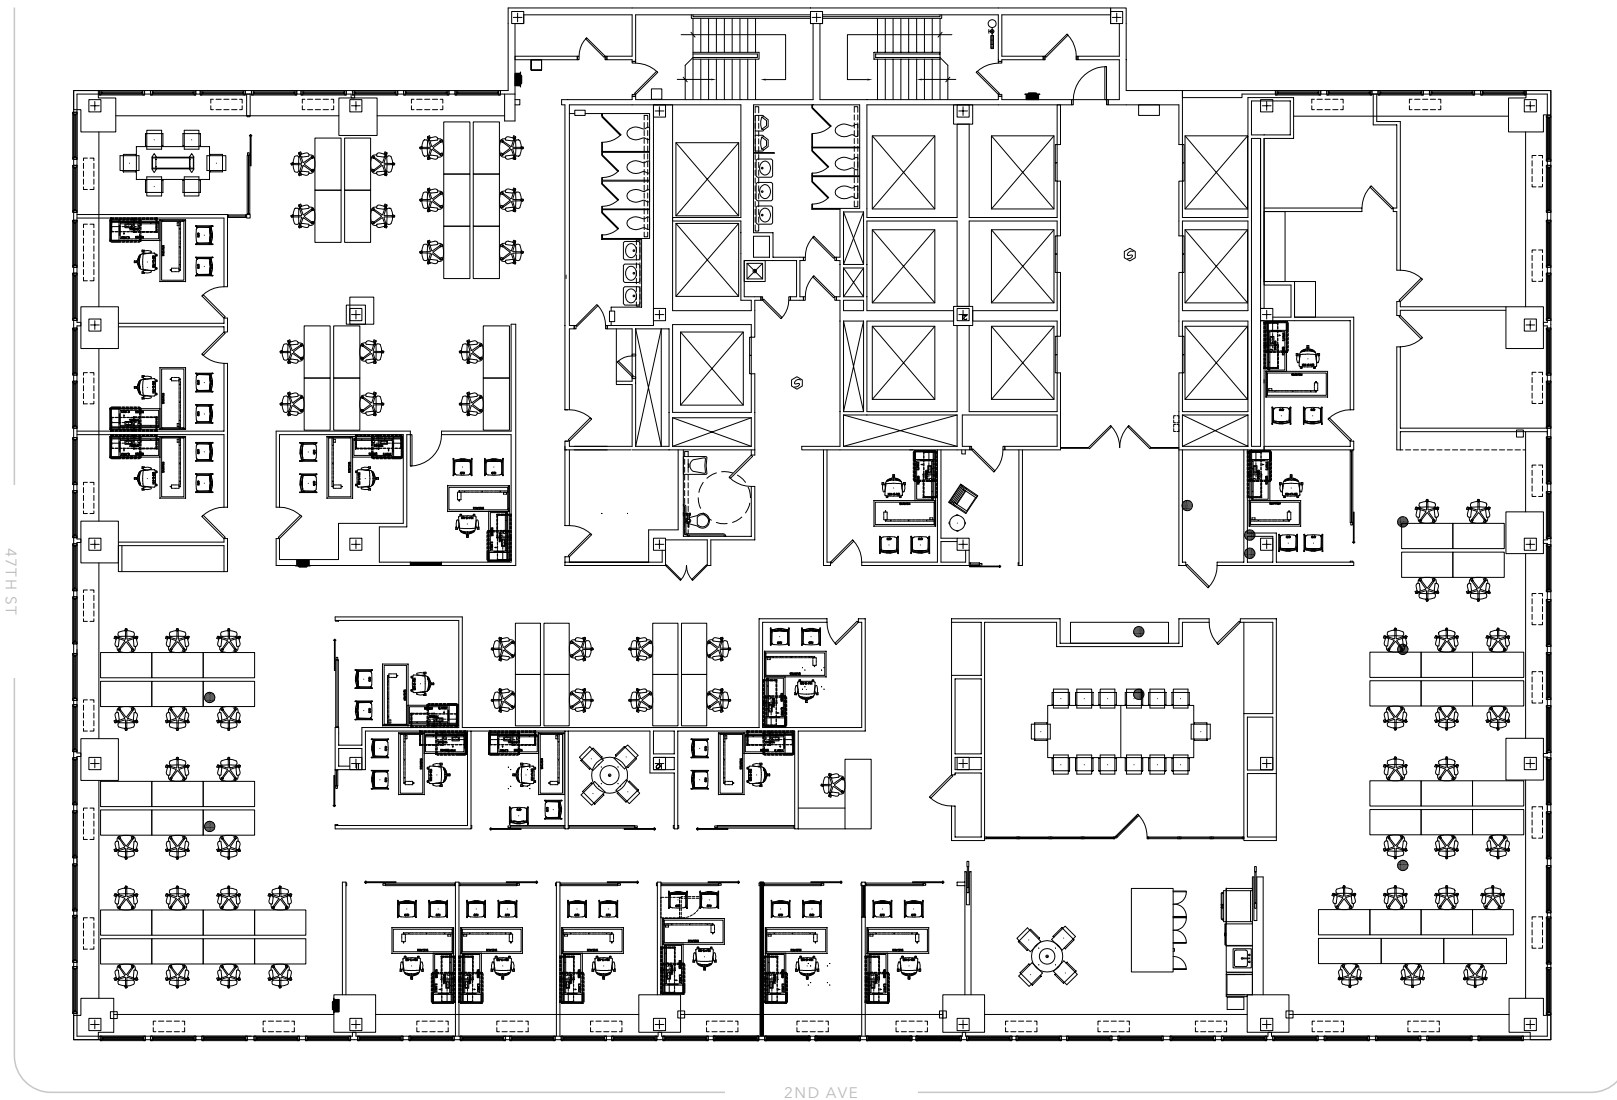

47TH ST

48TH ST

2ND AVE

Paul Amrich | +1 212.984.8122 | paul.amrich@cbre.com
Neil King | +1 212.984.8352 | neil.king@cbre.com
James Ackerson | +1 212.984.6647 | james.ackerson@cbre.com
Alex D'Amario | +1 212.984.6697 | alex.damario@cbre.com

ROCKPOINT

CBRE

Rockhill
MANAGEMENT

WWW.ONEDAG.COM