



A	T
R	I
U	M
1	7
0	0

SUITE 1000 | 4,843 SF

AS-BUILT

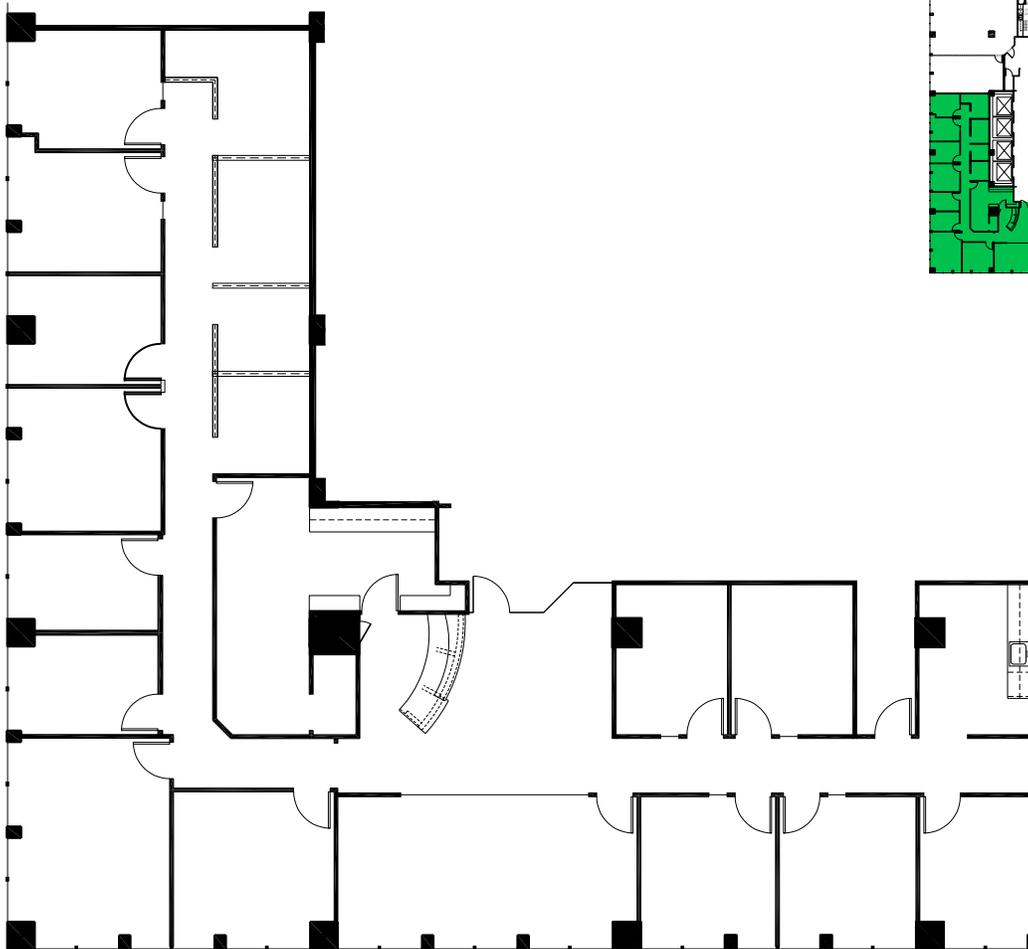

Key Plan

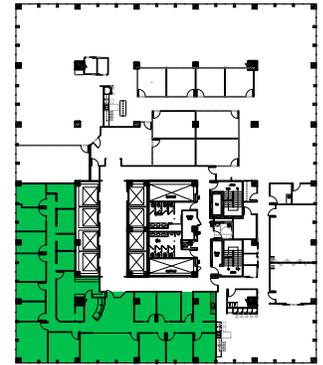

LEASING

Allison Berry
303-628-7456

allison.berry@cbre.com

Sarajane Goodfellow
303-628-7414

sarajane.goodfellow@cbre.com

Chris Phenicie
303-628-7411

chris.phenicie@cbre.com

CBRE

BEACON
CAPITAL PARTNERS

DISTINCTIVE WORKPLACES
DISTINCTLY DENVER