



A	T
R	I
U	M
1	7
0	0

## SUITE 620 | 3,557 SF

AS-BUILT

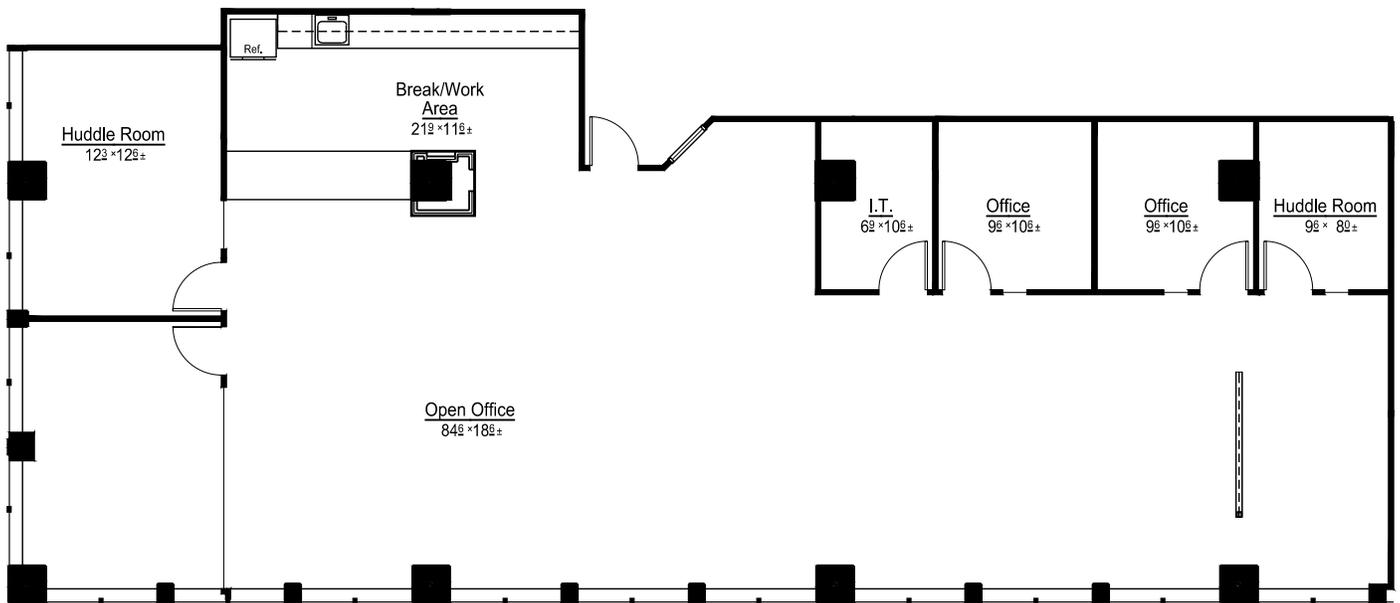

### Key Plan

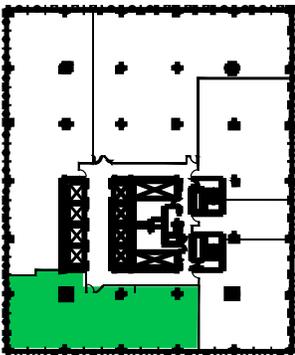

### LEASING

**Allison Berry**  
303-628-7456

[allison.berry@cbre.com](mailto:allison.berry@cbre.com)

**Sarajane Goodfellow**  
303-628-7414

[sarajane.goodfellow@cbre.com](mailto:sarajane.goodfellow@cbre.com)

**Chris Phenicie**  
303-628-7411

[chris.phenicie@cbre.com](mailto:chris.phenicie@cbre.com)

**CBRE**

**BEACON**

CAPITAL PARTNERS

DISTINCTIVE WORKPLACES  
DISTINCTLY DENVER