


|   |   |
|---|---|
| A | T |
| R | I |
| U | M |
| 1 | 7 |
| 0 | 0 |

## 20TH FLOOR | 20,887 SF

AS-BUILT

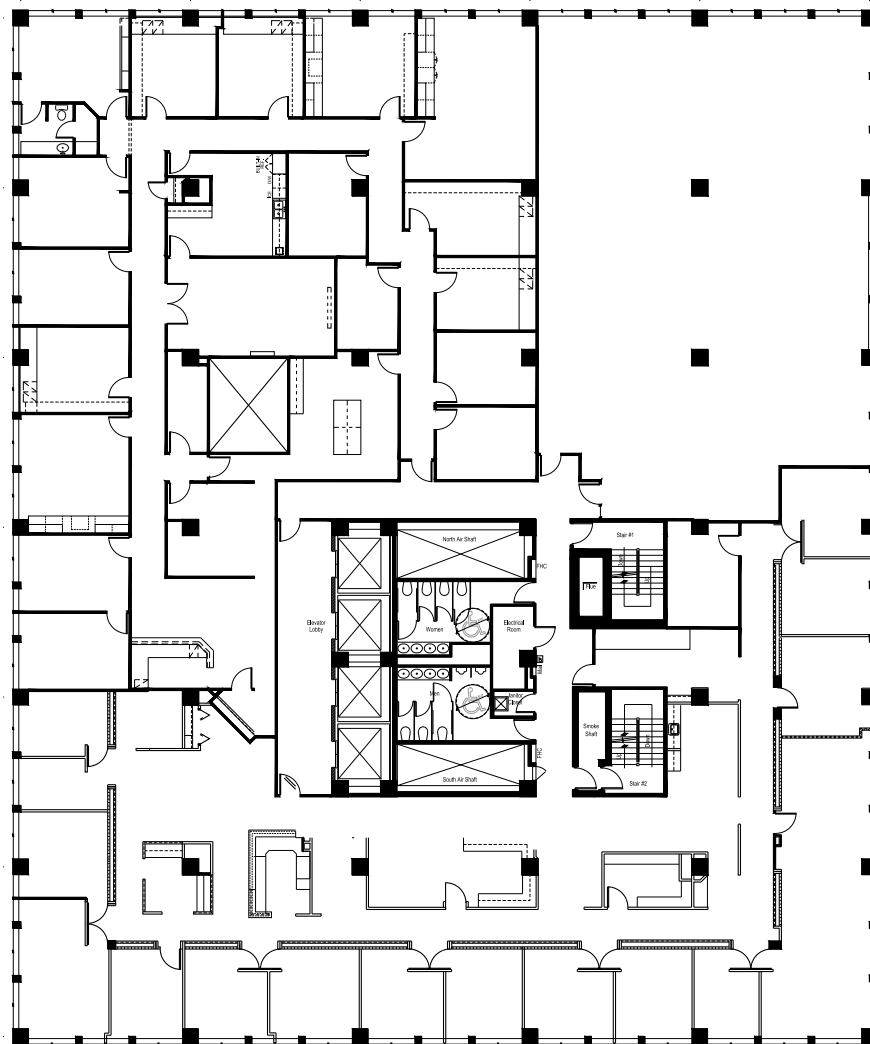

### LEASING

**Allison Berry**  
303-628-7456

[allison.berry@cbre.com](mailto:allison.berry@cbre.com)

**Sarajane Goodfellow**  
303-628-7414

[sarajane.goodfellow@cbre.com](mailto:sarajane.goodfellow@cbre.com)

**Chris Phenicie**  
303-628-7411

[chris.phenicie@cbre.com](mailto:chris.phenicie@cbre.com)

**CBRE**

**BEACON**  
CAPITAL PARTNERS

DISTINCTIVE WORKPLACES  
DISTINCTLY DENVER

© 2020 CBRE, Inc. All rights reserved. This information has been obtained from sources believed reliable, but has not been verified for accuracy or completeness. You should conduct a careful, independent investigation of the property and verify all information. Any reliance on this information is solely at your own risk. CBRE and the CBRE logo are service marks of CBRE, Inc. All other marks displayed on this document are the property of their respective owners. Photos herein are property of their respective owners. Use of images without express written consent from the owner is prohibited.