



THE VAULT

Office Plan

As-built

Level: 7th

Location: Full Floor

Type: Office


Square Footage: 11,938

Contact:

Chris Phenicie, CBRE
303-628-7411
chris.phenicie@cbre.com

Allison Berry, CBRE
303-628-7456
allison.berry@cbre.com

Sarajane Goodfellow, CBRE
303-628-7414
sarajane.goodfellow@cbre.com

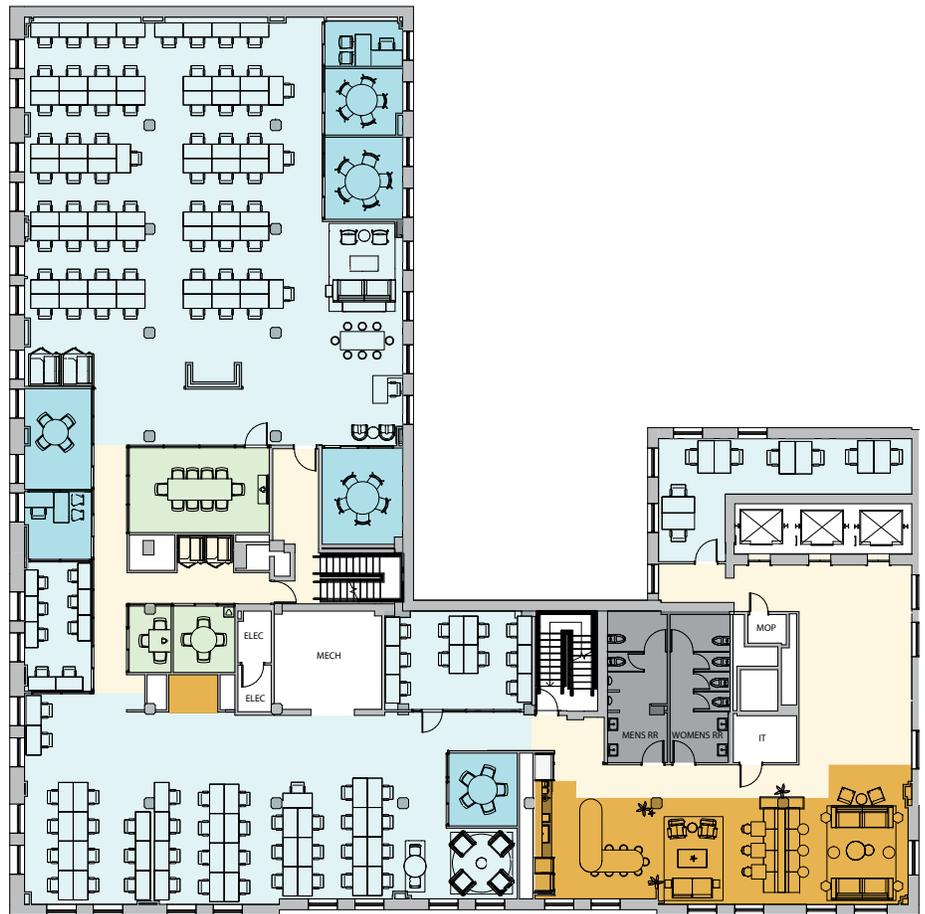

821 17th Street
Denver, Colorado

www.thevaultbuilding.com