



Floor 5 \ Market Ready Suites


FURNITURE PLANS



FLOOR 5



SUITE 528
7,704 SF

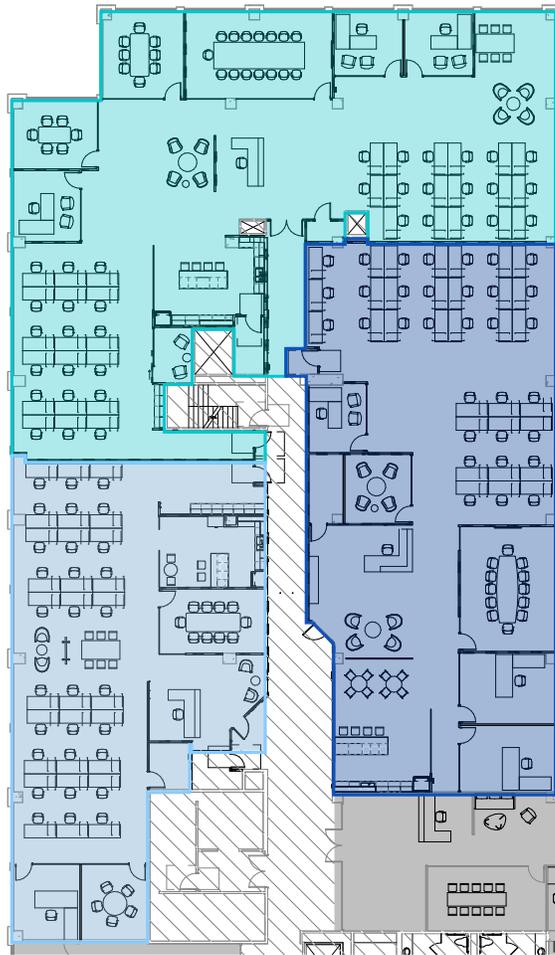

SUITE 558
6,163 SF

SUITE 508
Conceptual Plan*
4,536 SF

* Suite 508: plan does not show existing condition



CONTACT INFORMATION

TIM OWENS
Senior Vice President
+1 425 462 6913
tim.owens@cbre.com

RILEY SHEPHARD
First Vice President
+1 425 462 6932
riley.shephard@cbre.com






Floor 5 \ Market Ready Suites

AS-BUILT PLANS



SUITE 528
7,704 SF

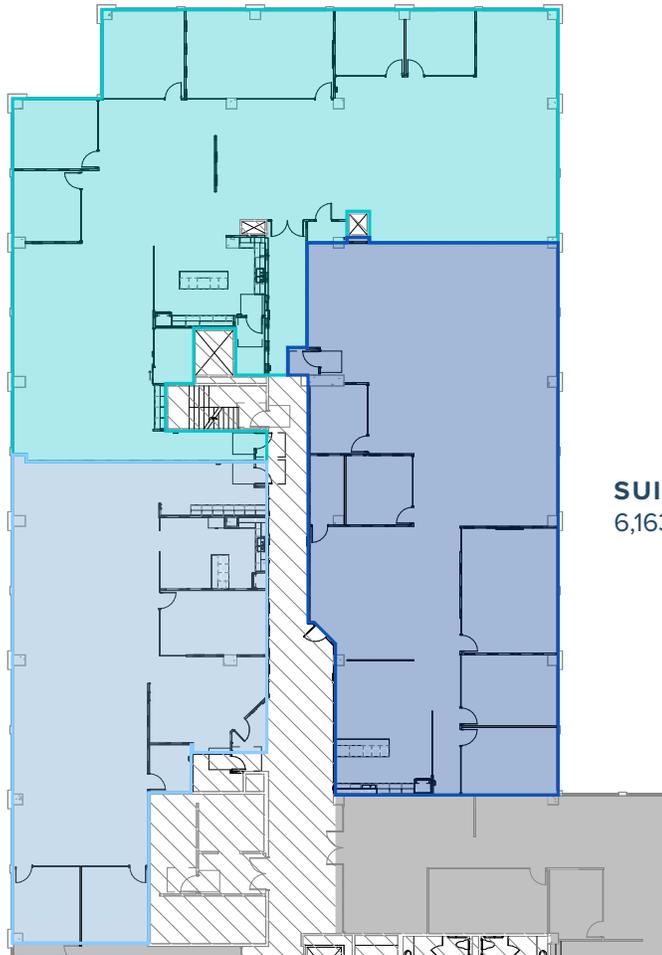

SUITE 558
6,163 SF

SUITE 508
Conceptual Plan*
4,536 SF

* Suite 508: plan does not show existing condition



CONTACT INFORMATION

TIM OWENS
Senior Vice President
+1 425 462 6913
tim.owens@cbre.com

RILEY SHEPHARD
First Vice President
+1 425 462 6932
riley.shephard@cbre.com

