


CLASS A OFFICE FOR LEASE

OVERLAKE 520

FURNITURE PLAN

EAST BUILDING | SUITE 200 | 17,622 SF

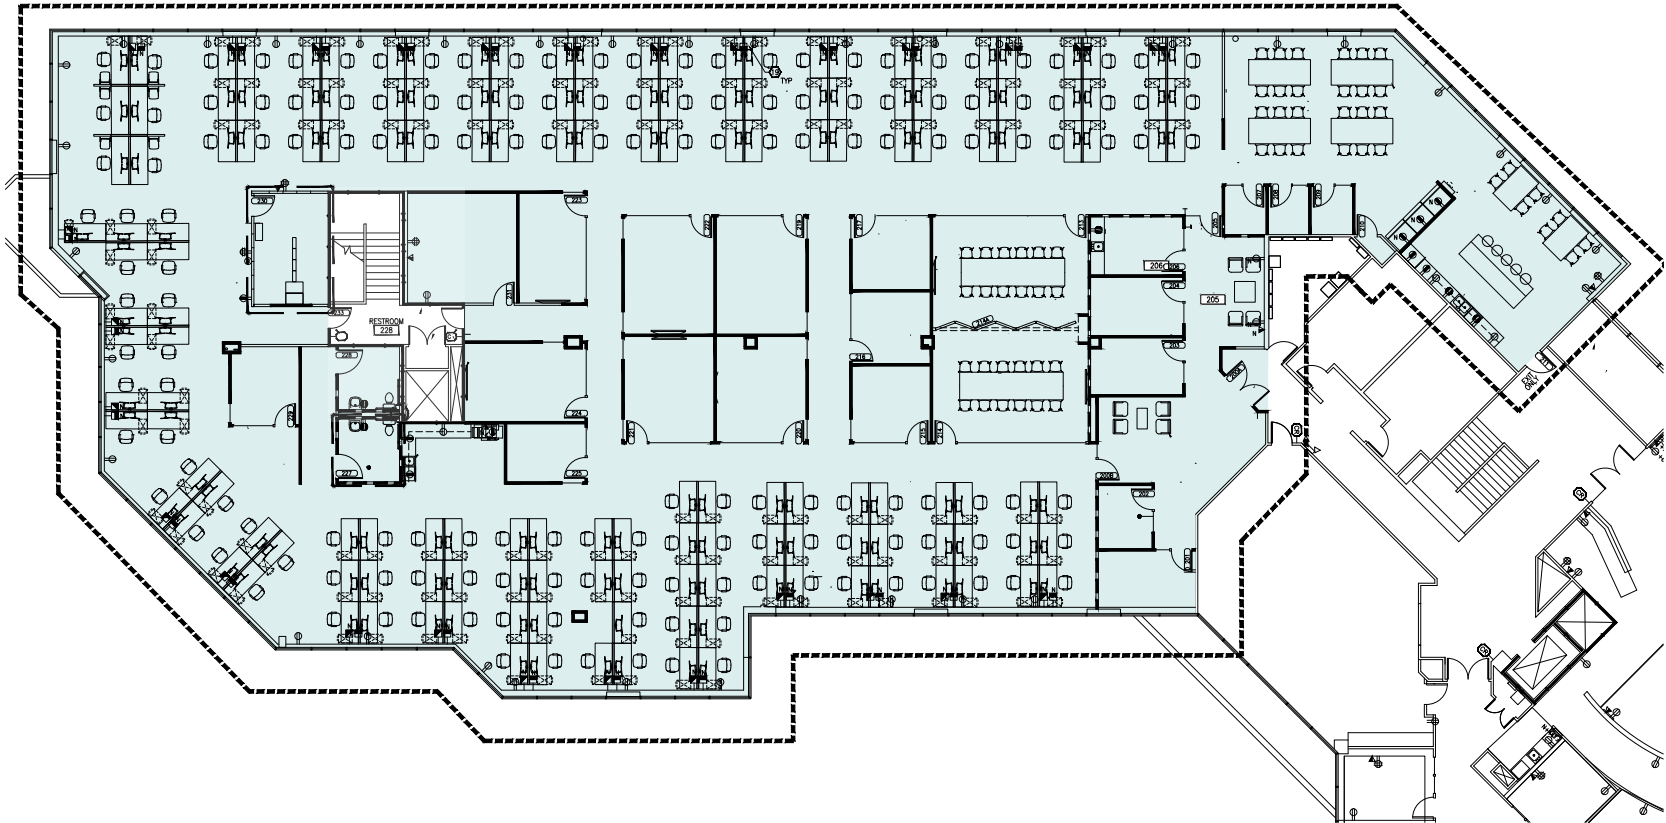

BROKER CONTACTS

SCOTT DAVIS

Executive Vice President
+1 425 941 7573
scott.davis@cbre.com

TIM OWENS

Senior Vice President
+1 425 462 6913
tim.owens@cbre.com

LENNON ATTEBERRY

Senior Vice President
+1 425 462 6991
Lennon.attedberry@cbre.com

CBRE, INC

929 108th Ave NE
Suite 700
Bellevue, WA 98004

INNOVATUS
CAPITAL PARTNERS, LLC

LEASING

CBRE

MANAGEMENT

LPCWEST
LINCOLN PROPERTY COMPANY


© 2025 CBRE, Inc. All rights reserved. This information has been obtained from sources believed reliable, but has not been verified for accuracy or completeness. You should conduct a careful, independent investigation of the property and verify all information. Any reliance on this information is solely at your own risk. CBRE and the CBRE logo are service marks of CBRE, Inc. All other marks displayed on this document are the property of their respective owners. Photos herein are the property of their respective owners. Use of these images without the express written consent of the owner is prohibited.

CLASS A OFFICE FOR LEASE

OVERLAKE 520

AS-BUILT PLAN

EAST BUILDING | SUITE 200 | 17,622 SF

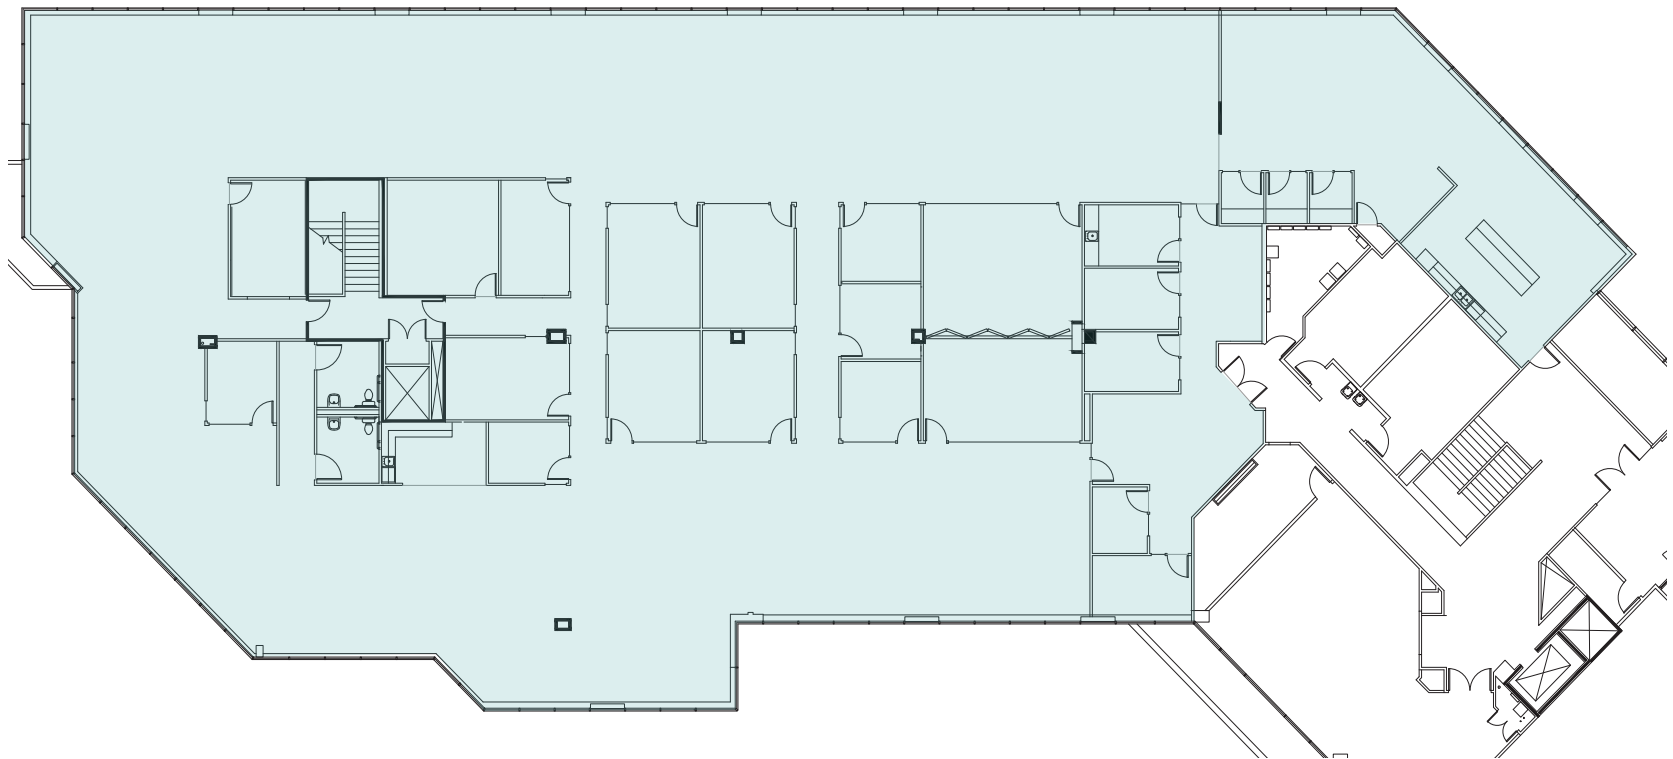

BROKER CONTACTS

SCOTT DAVIS

Executive Vice President
+1 425 941 7573
scott.davis@cbre.com

TIM OWENS

Senior Vice President
+1 425 462 6913
tim.owens@cbre.com

LENNON ATTEBERRY

Senior Vice President
+1 425 462 6991
Lennon.attedberry@cbre.com

CBRE, INC

929 108th Ave NE
Suite 700
Bellevue, WA 98004

INNOVATUS CAPITAL PARTNERS, LLC

LEASING

CBRE

MANAGEMENT

LPCWEST
LINCOLN PROPERTY COMPANY

© 2025 CBRE, Inc. All rights reserved. This information has been obtained from sources believed reliable, but has not been verified for accuracy or completeness. You should conduct a careful, independent investigation of the property and verify all information. Any reliance on this information is solely at your own risk. CBRE and the CBRE logo are service marks of CBRE, Inc. All other marks displayed on this document are the property of their respective owners. Photos herein are the property of their respective owners. Use of these images without the express written consent of the owner is prohibited.