


Key Plan

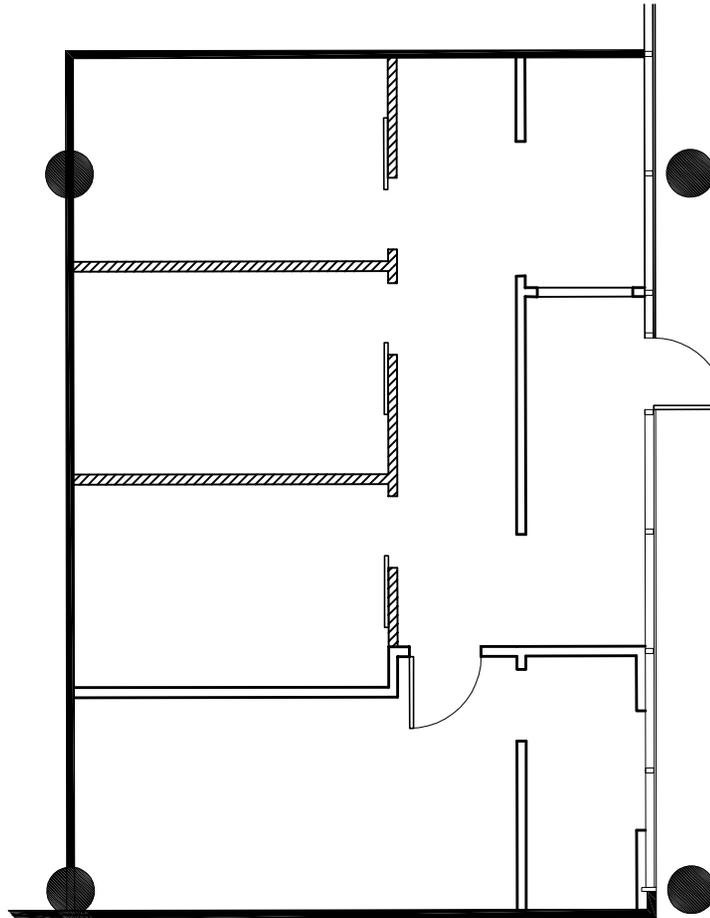

Building North Scale: $\frac{1}{8}'' = 1'-0''$

• Interior conditions have not been verified by NELSON

CBRE

Jeff Keppen 404.504.7923

Katherine Lynch 404.504.5971

Nicole Goldsmith 404.504.7923

NELSON **Concourse II • Suite 160 • 1,008 RSF**

As Built