


Key Plan

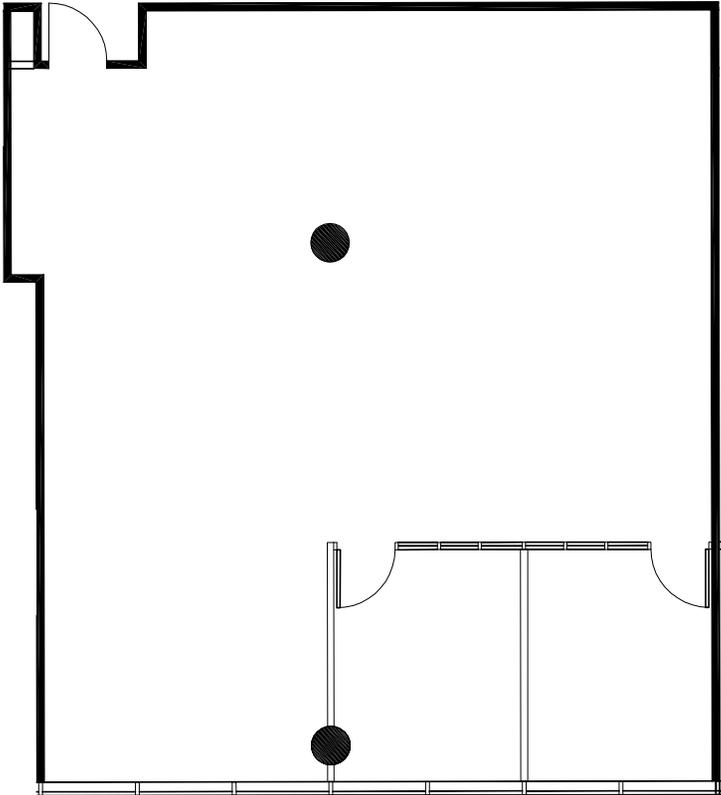

Building North

0 5 10 20

• Interior conditions have not been verified by NELSON



Jeff Keppen 404.504.7923
Katherine Lynch 404.504.5971
Nicole Goldsmith 404.504.7923

NELSON Concourse IV • Suite 220 • 1,828 RSF

As Built