



Key Plan

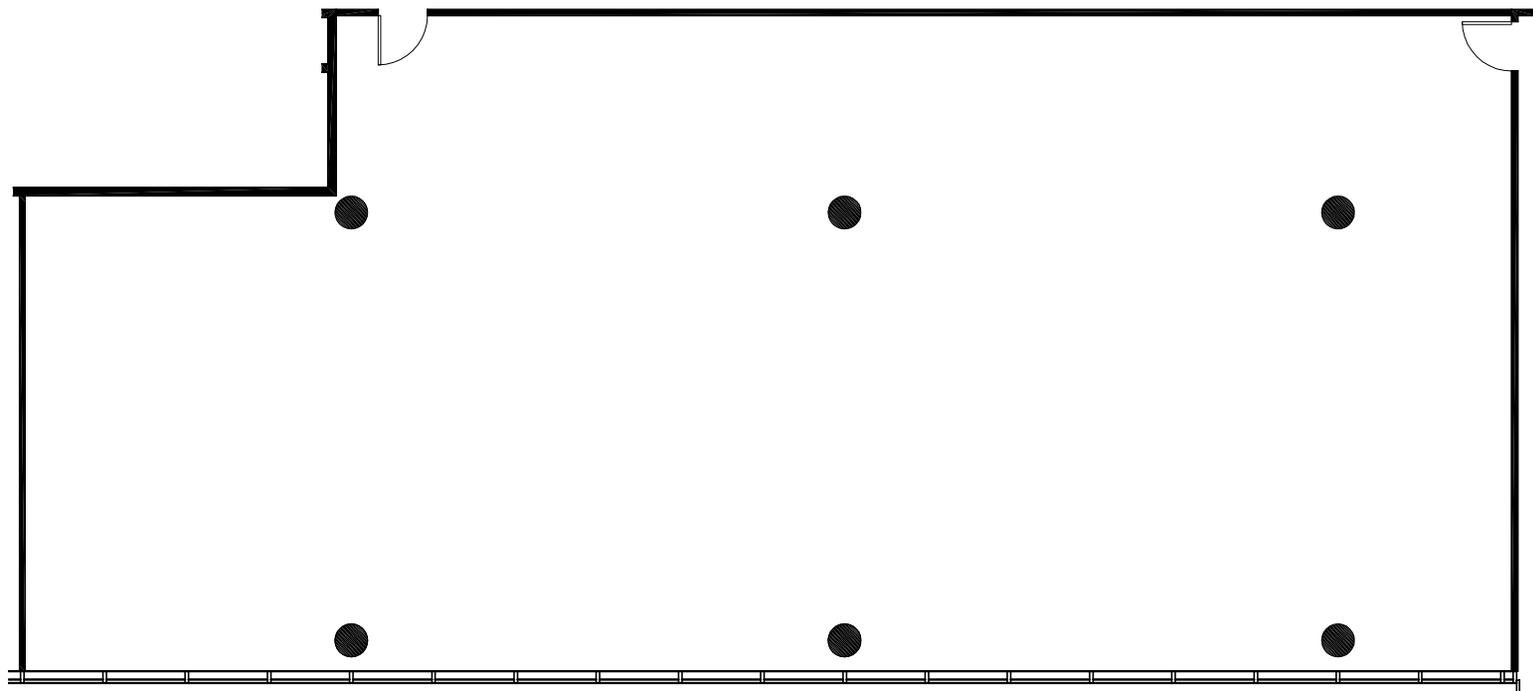

Building North

• Interior conditions have not been verified by NELSON

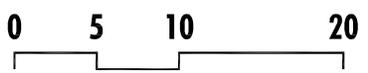

CBRE

Jeff Keppen 404.504.7923
Katherine Lynch 404.504.5971
Nicole Goldsmith 404.504.7923

NELSON Concourse IV • Suite 135 • 4,262 RSF

As Built