



Key Plan

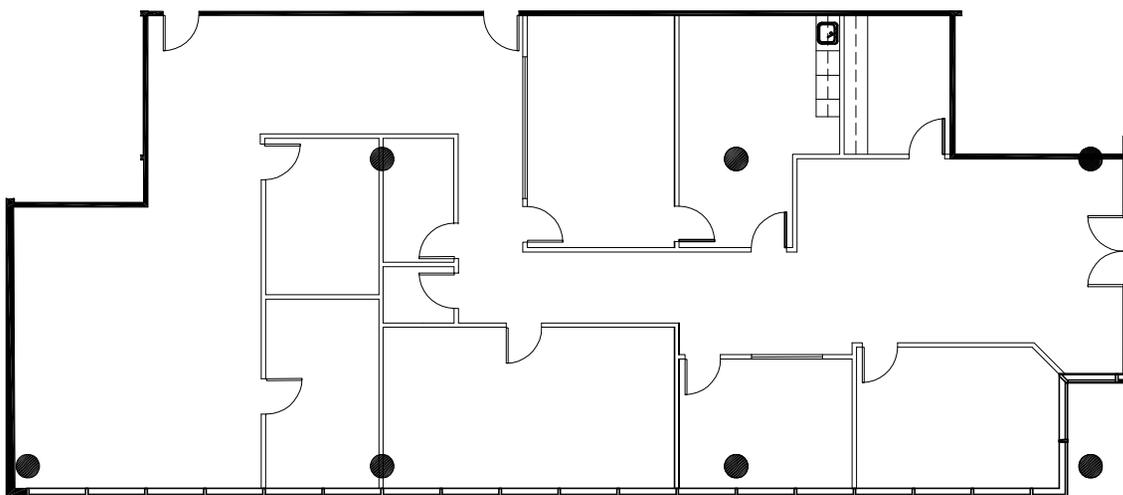

North

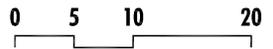

• Interior conditions have not been verified by NELSON



Jeff Keppen 404.504.7923
Katherine Lynch 404.504.5971
Nicole Goldsmith 404.504.7923

NELSON Concourse IV • Suite 155 • 4,204 RSF

As Built