


Available Suites

1528 E WILLIAMS FIELD RD

SUITE 205: $\pm 6,403$ SF¹ | \$32.00 SF NNN | ¹CONTIGUOUS TO $\pm 14,579$ SF

AS-BUILT FLOOR PLAN

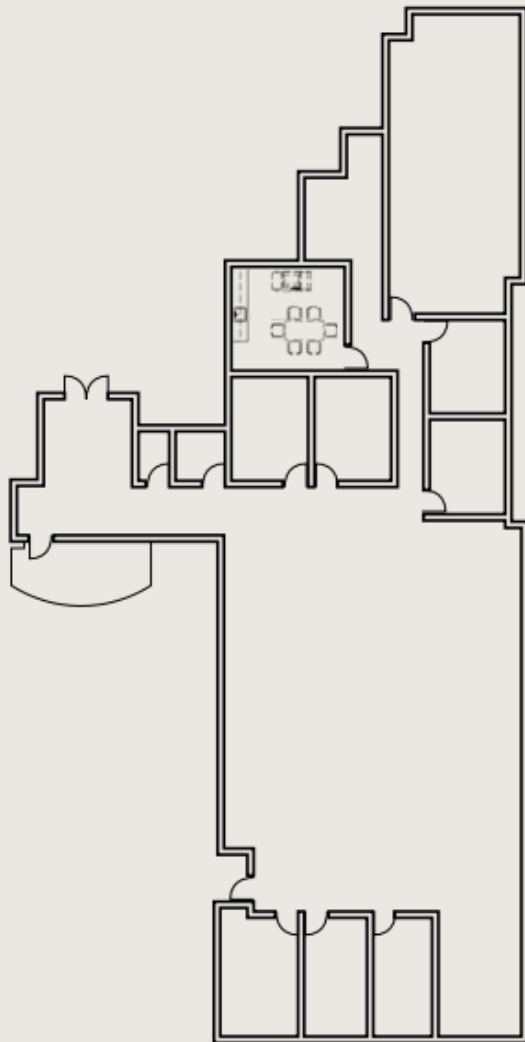

CONCEPTUAL FLOOR PLAN

