


Available Suites


1530 E WILLIAMS FIELD RD

SUITE 206: $\pm 1,688$ SF | \$32.00 SF NNN

AS-BUILT FLOOR PLAN

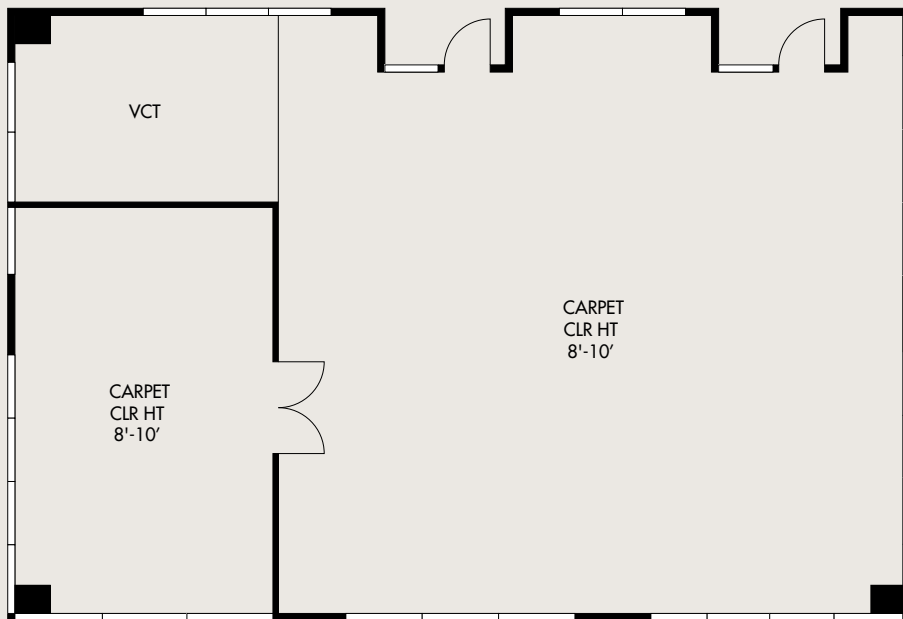

CONCEPTUAL OFFICE FLOOR PLAN

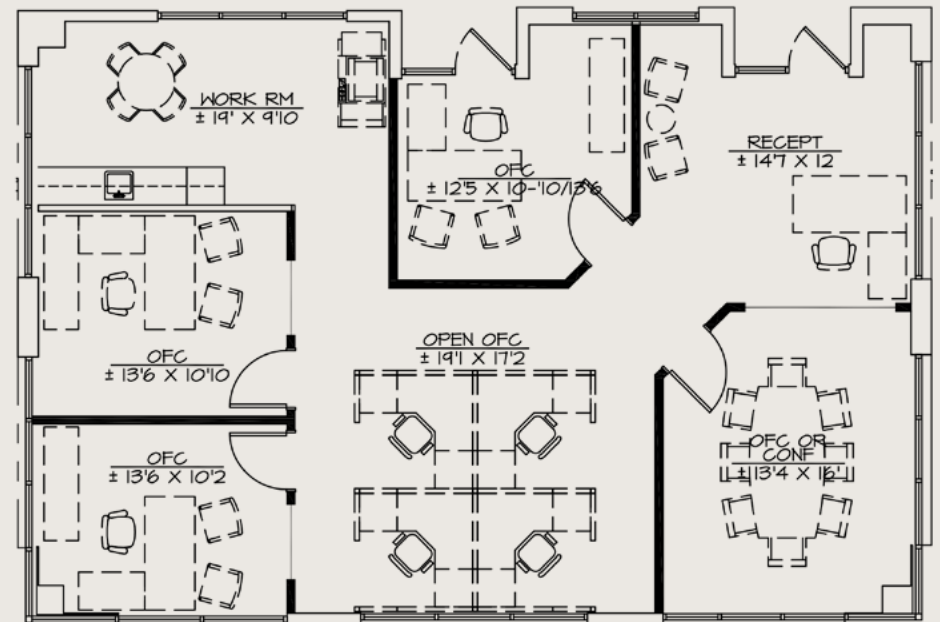

Available Suites

1530 E WILLIAMS FIELD RD

SUITE 206: $\pm 1,688$ SF | \$32.00 SF NNN

CONCEPTUAL MEDICAL FLOOR PLAN

