


# Available Suites

1530 E WILLIAMS FIELD RD

SUITE 206: ±1,688 SF (AVAILABLE 08/01/2026) | \$32.00 SF NNN

## AS-BUILT FLOOR PLAN

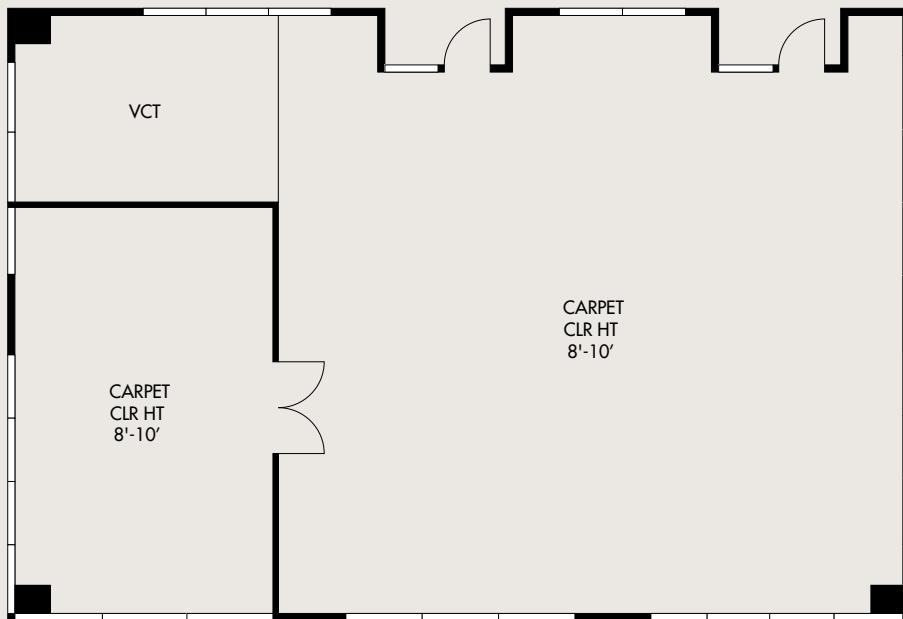

## CONCEPTUAL FLOOR PLAN

