


Available Suites

1528 E WILLIAMS FIELD RD

SUITE 205: ±6,403 SF¹ | \$31.00 SF NNN | ¹CONTIGUOUS TO ±14,579 SF


AS-BUILT FLOOR PLAN

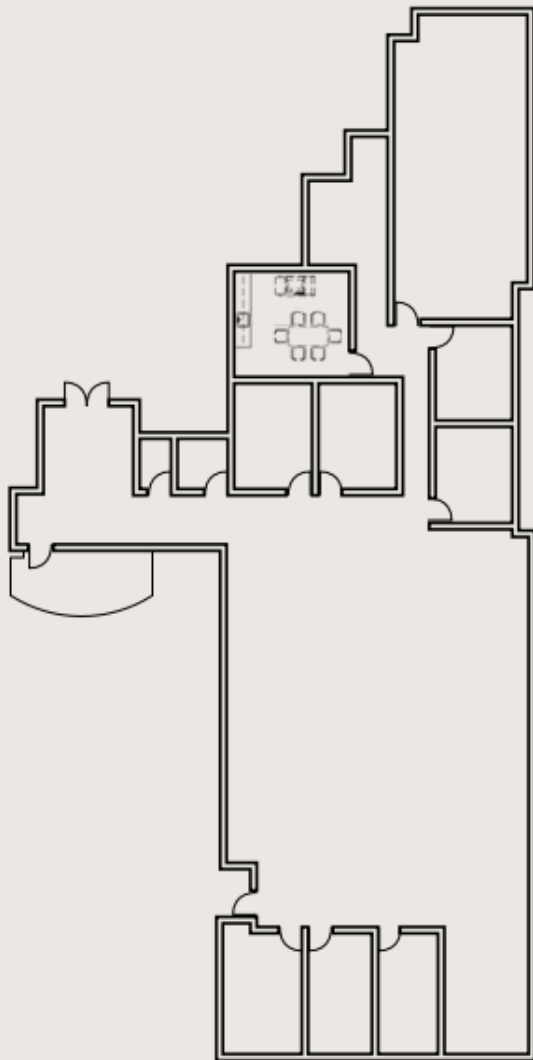

[Click Here For Virtual Tour](#)



CONCEPTUAL OFFICE FLOOR PLAN: OPEN LAYOUT

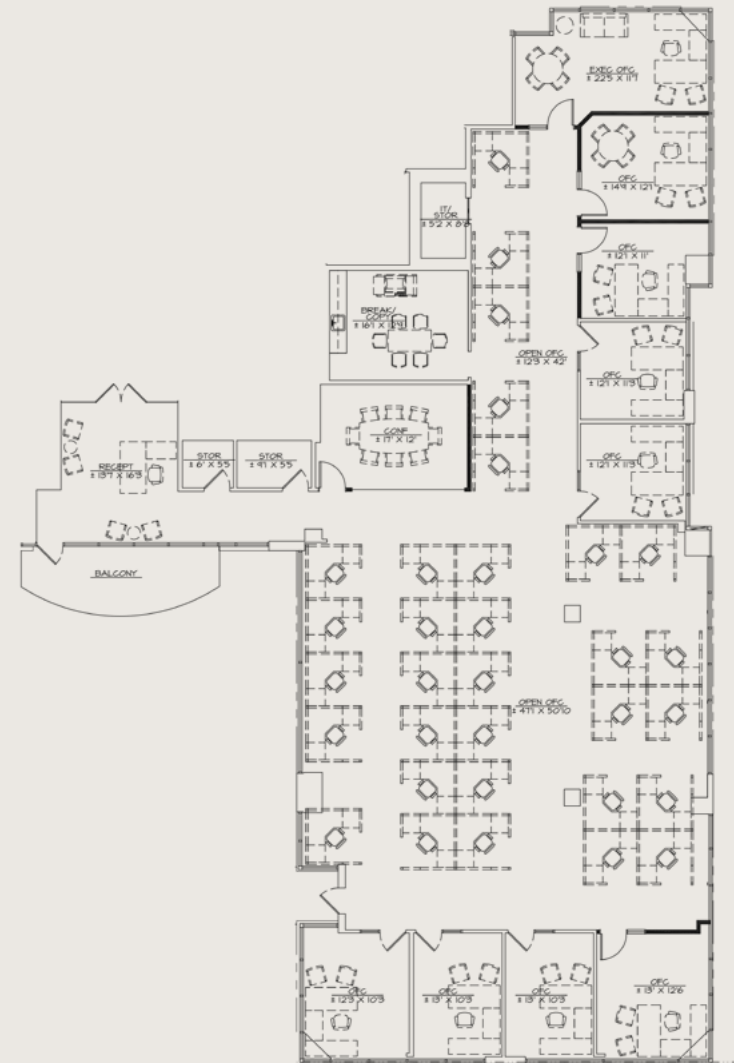


Available Suites

1528 E WILLIAMS FIELD RD

SUITE 205: $\pm 6,403$ SF¹ | \$31.00 SF NNN | ¹CONTIGUOUS TO $\pm 14,579$ SF

CONCEPTUAL OFFICE FLOOR PLAN: PRIVATE OFFICES LAYOUT

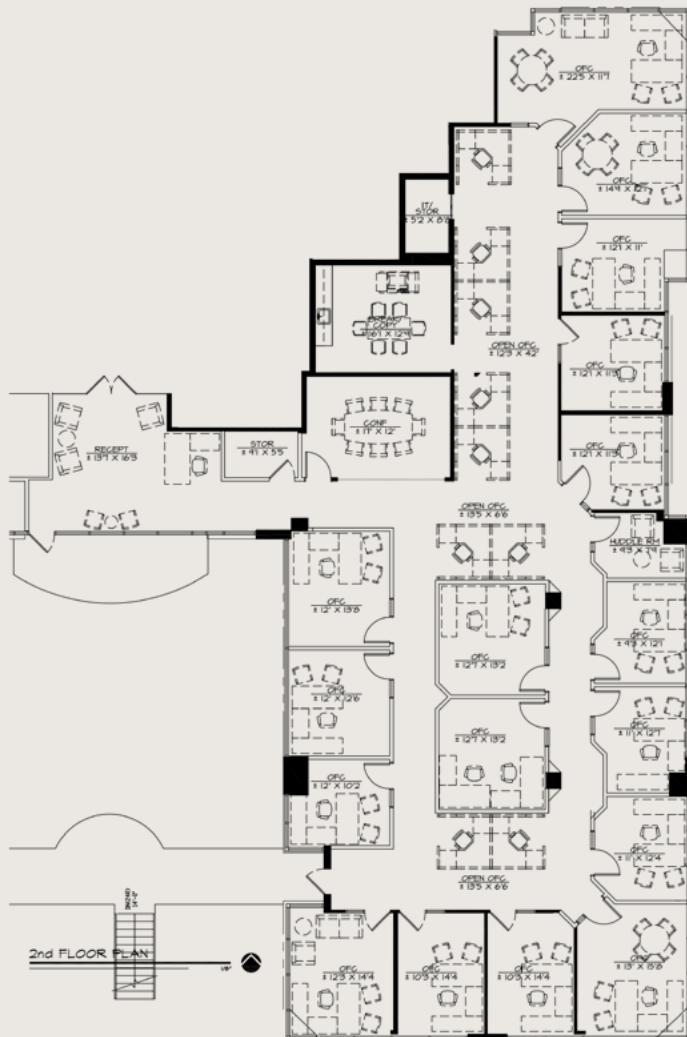

CONCEPTUAL MEDICAL FLOOR PLAN

