



SUITE 560  
AS-BUILT PLAN - 1 OF 1  
4601 PARK ROAD  
2,595 RSF  
SCALE: 3/32" = 1'-0"  
DATE: DECEMBER 18, 2019

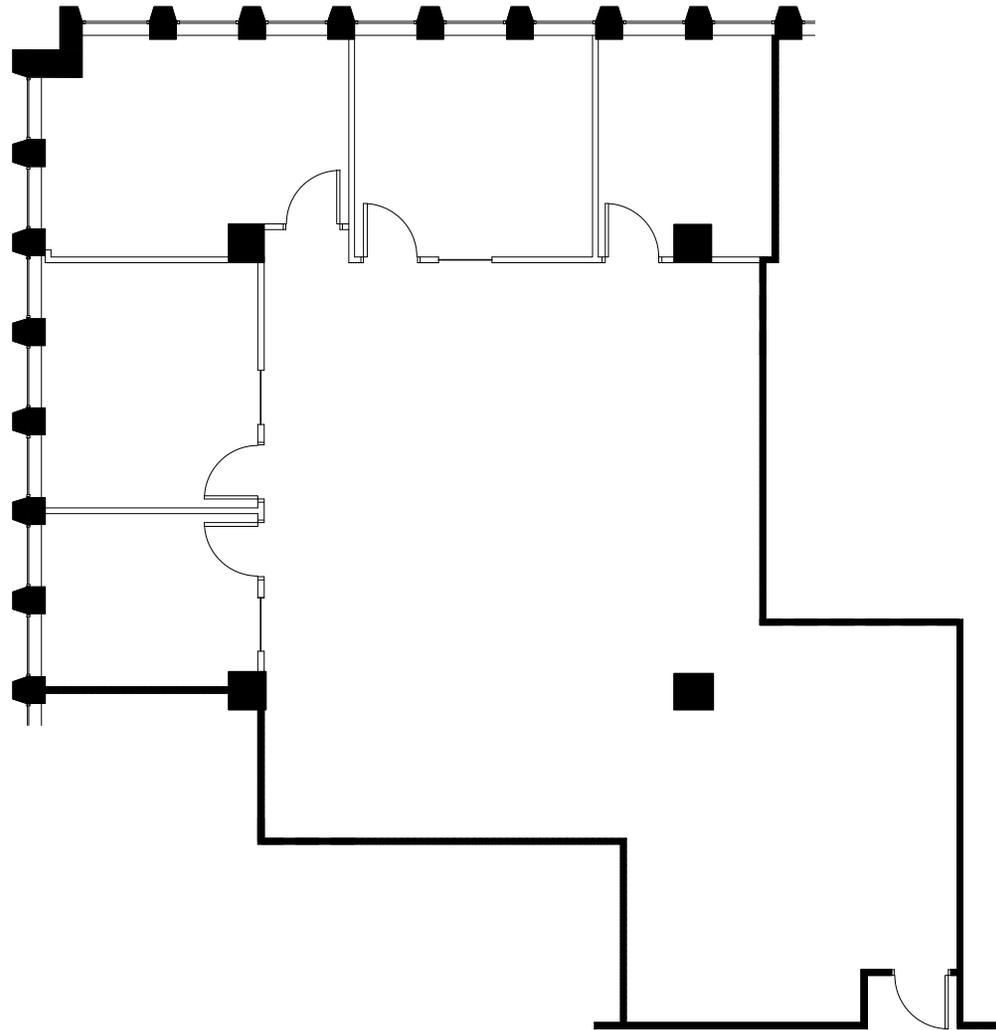

**CBRE**

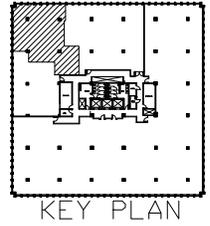

**SMITH  
HARRIS**  
**DESIGN**  
associates