


**FLOOR  
 PLAN**

MILES BUILDING  
 1ST FLOOR  
 4135 S. 100TH E.  
 AVE., TULSA, OK


TR OFFICE  
 PARK

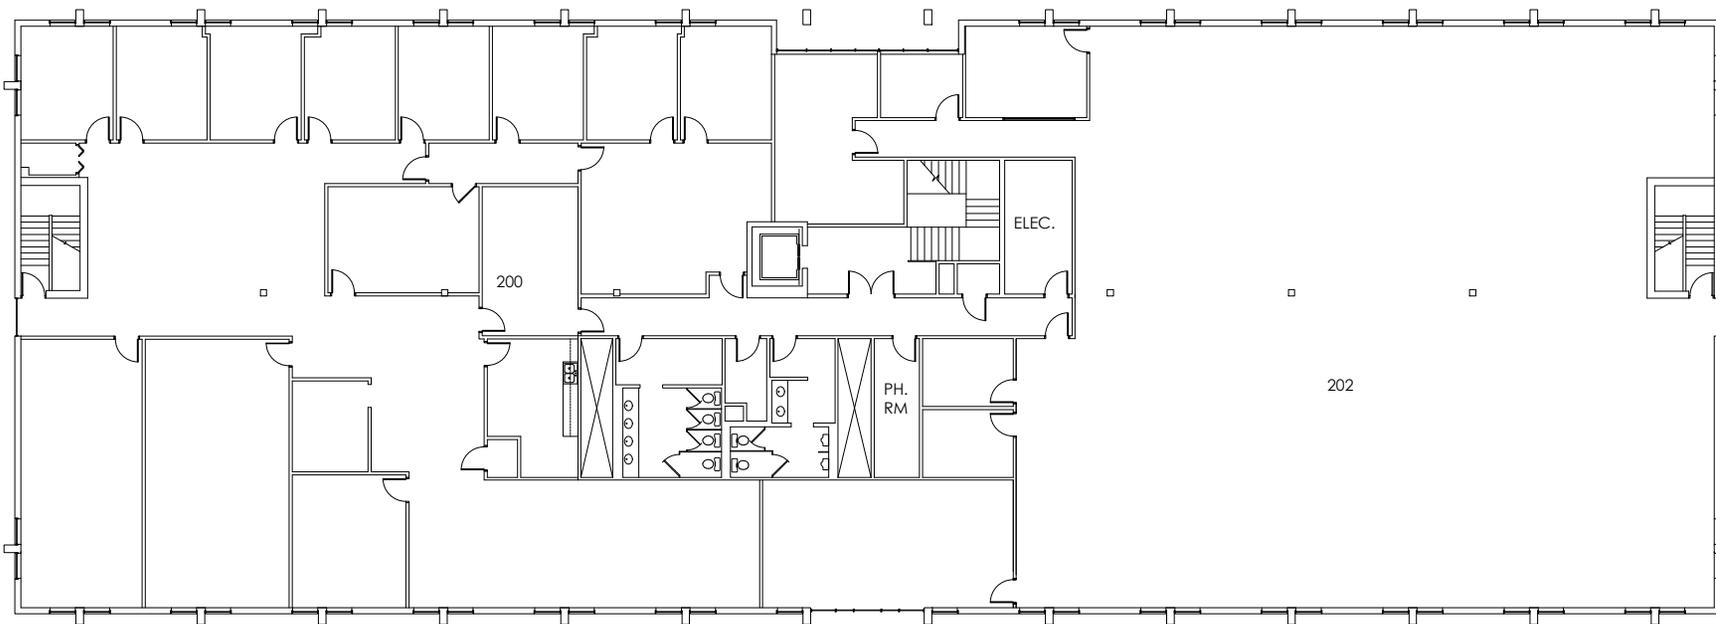

SUITE 200  
 AVAILABLE  
 7810 RSF

SUITE 202  
 AVAILABLE  
 9426 RSF


**A FLOOR PLAN**   
 SCALE: N.T.S. NORTH

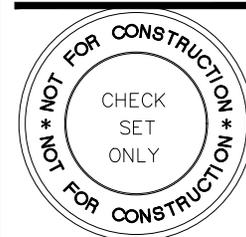

01.20.2023

AS-BUILT  
 PLAN

**AS.2**

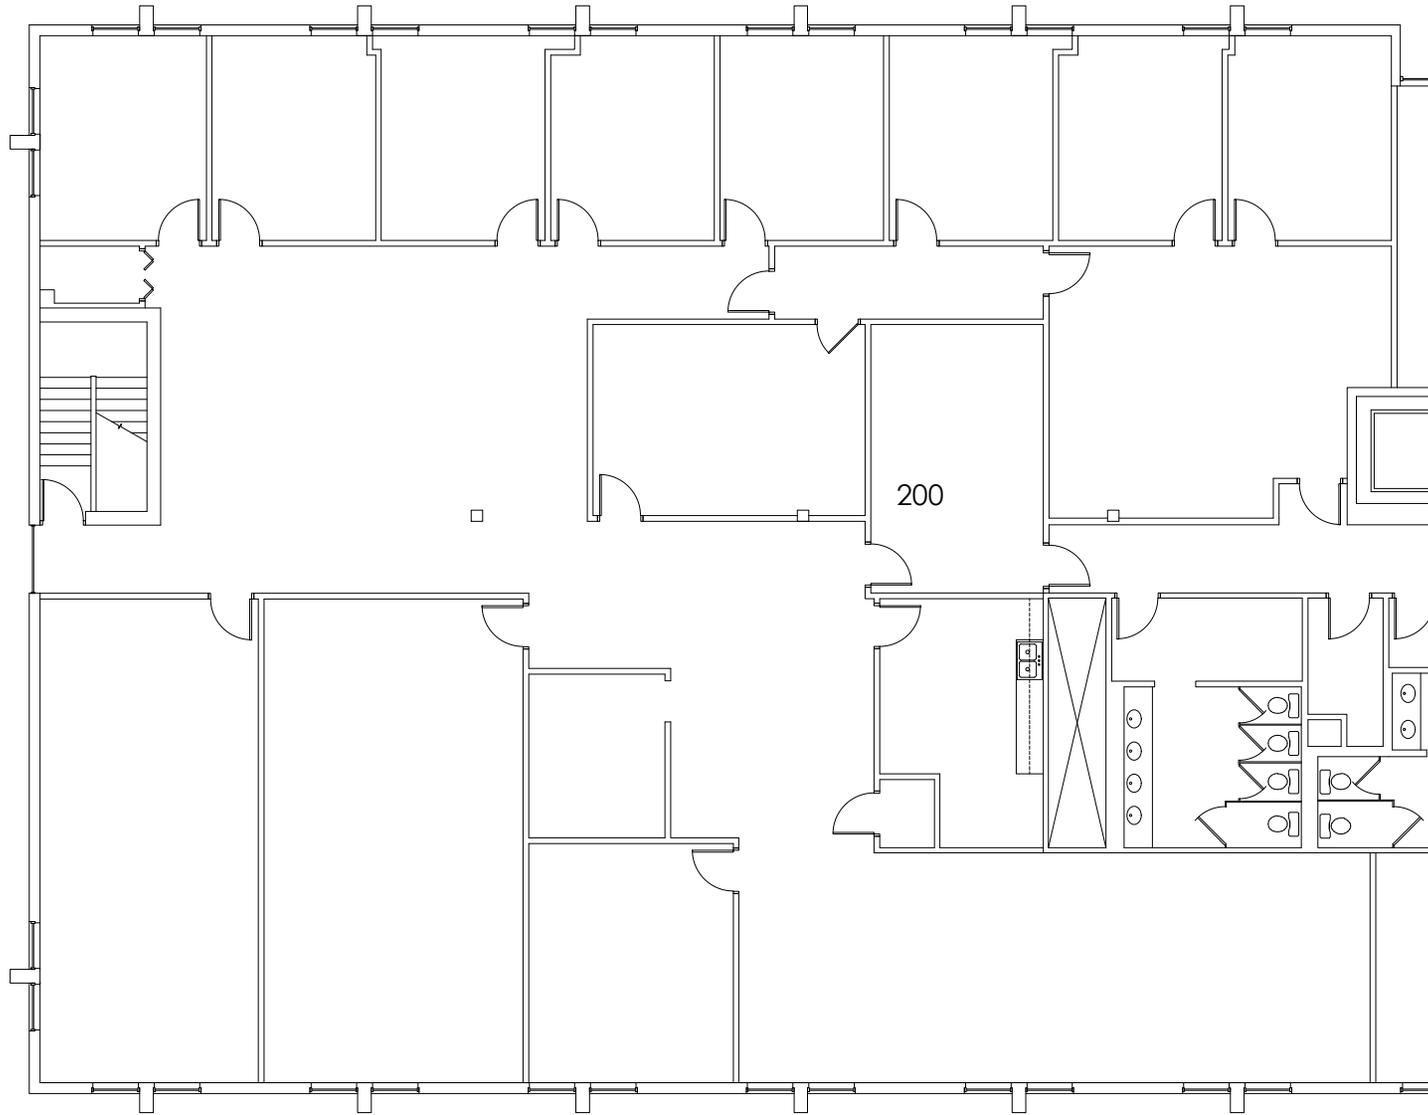

**A FLOOR PLAN**  NORTH  
SCALE: N.T.S.

SUITE 200  
AVAILABLE  
7810 RSF




**KKT ARCHITECTS, INC.**  
2200 SOUTH UTICA PLACE, SUITE 200  
TULSA, OKLAHOMA 74114  
[P] 918.744.4270 \ [F] 918.744.7849  
WWW.KKTARCHITECTS.COM  
C O F A # 534 6/30/23

**SUITE  
200**

MILES BUILDING  
2ND FLOOR  
4135 S. 100TH E.  
AVE., TULSA, OK

TR OFFICE  
PARK

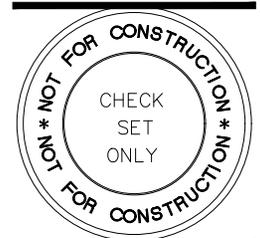


01.20.2023



AS-BUILT  
PLAN

**AS.2**

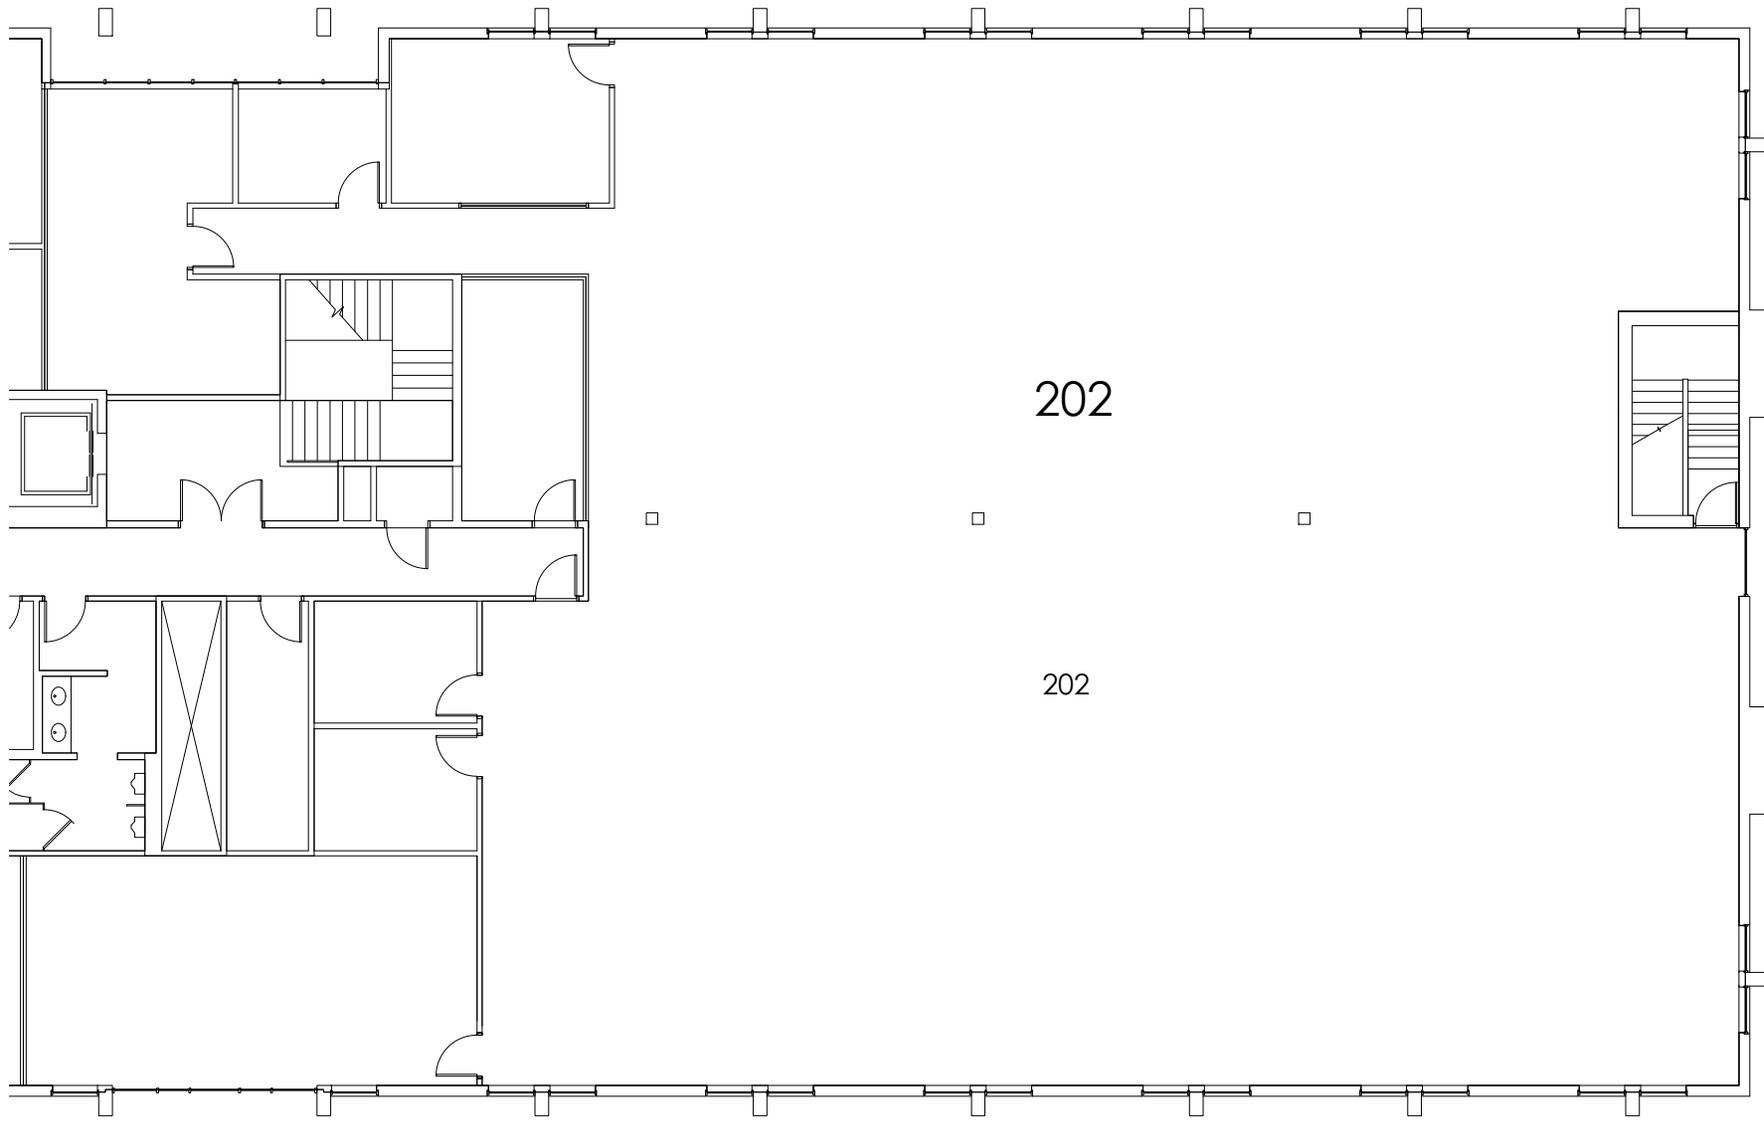


**KKT ARCHITECTS, INC.**  
2200 SOUTH UTICA PLACE, SUITE 200  
TULSA, OKLAHOMA 74114  
[P] 918.744.4270 \ [F] 918.744.7849  
WWW.KKTARCHITECTS.COM  
C O F A # 534 6/30/23

# SUITE 202

MILES BUILDING  
2ND FLOOR  
4135 S. 100TH E.  
AVE., TULSA, OK

TR OFFICE  
PARK

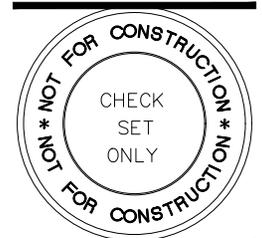

01.20.2023



AS-BUILT  
PLAN

# AS.2

# A FLOOR PLAN

SCALE: N.T.S.  NORTH

SUITE 202  
AVAILABLE  
9426 RSF