MEMORIAL TOWERS

LEVEL 8 | 1616 SOUTH VOSS RD

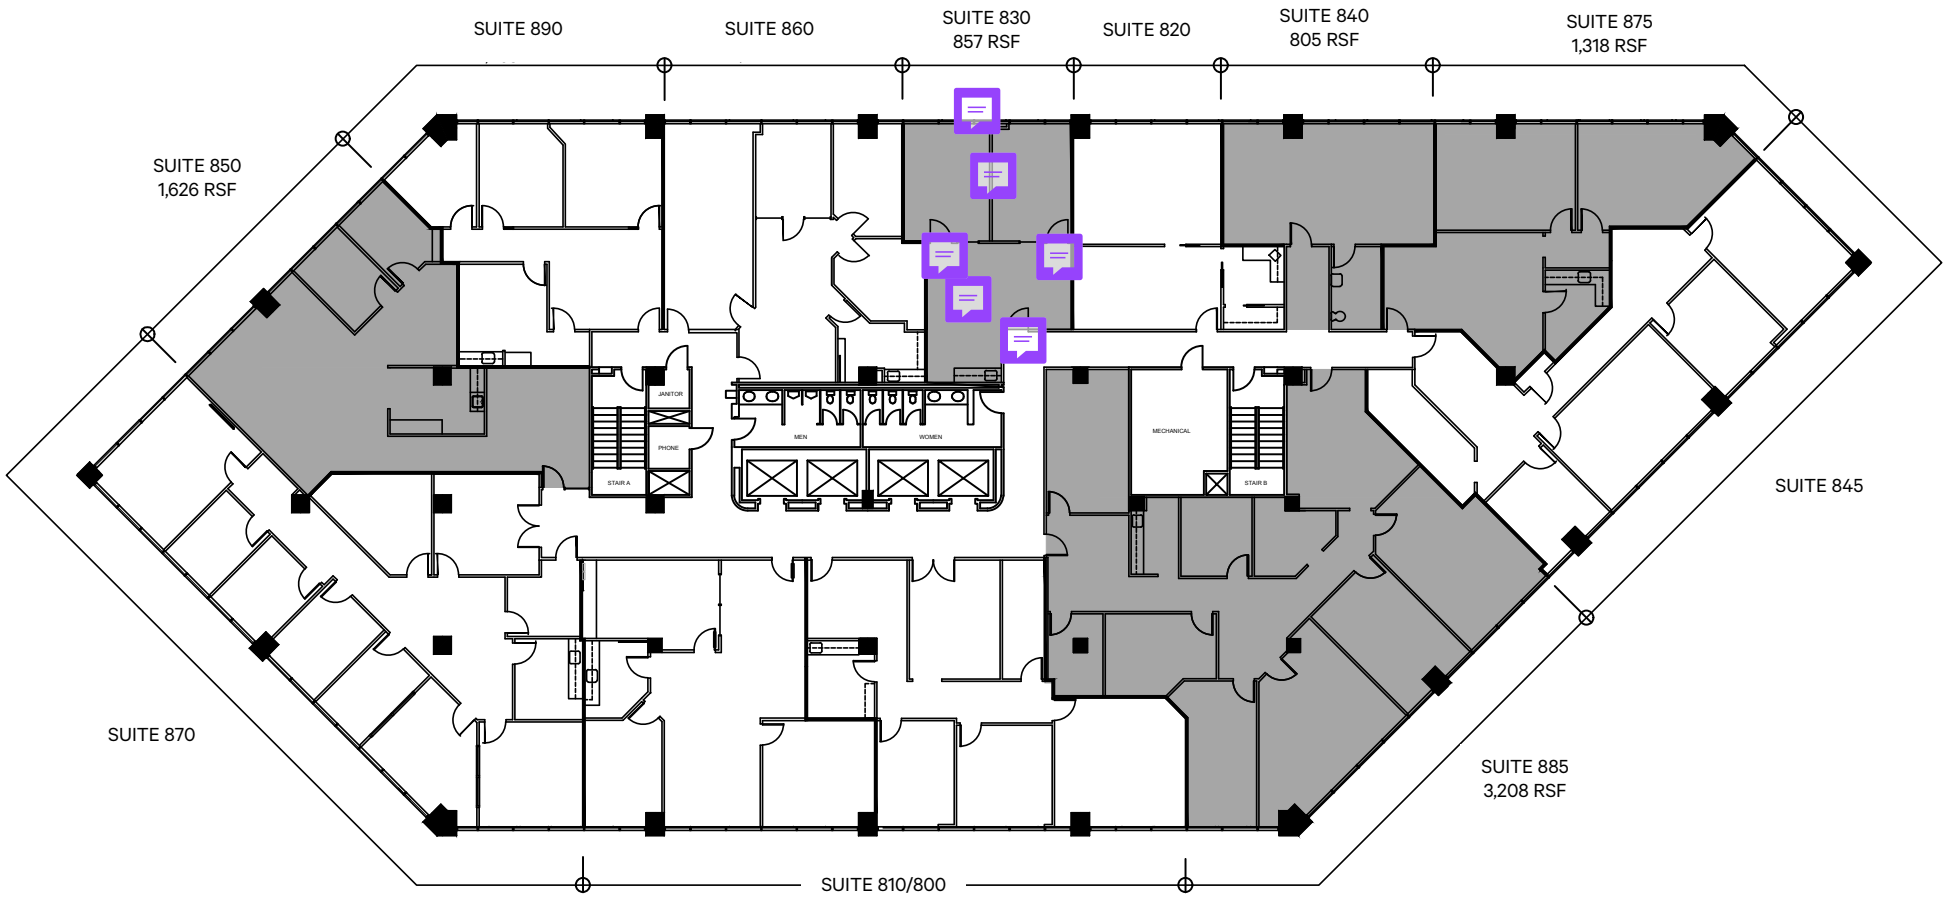

CONNOR SAXE | Senior Vice President | 713 577 1830 | connor.saxe@cbre.com
JOEL DOUTHIT | Senior Associate | 713 577 1573 | joel.douthit@cbre.com

CBRE