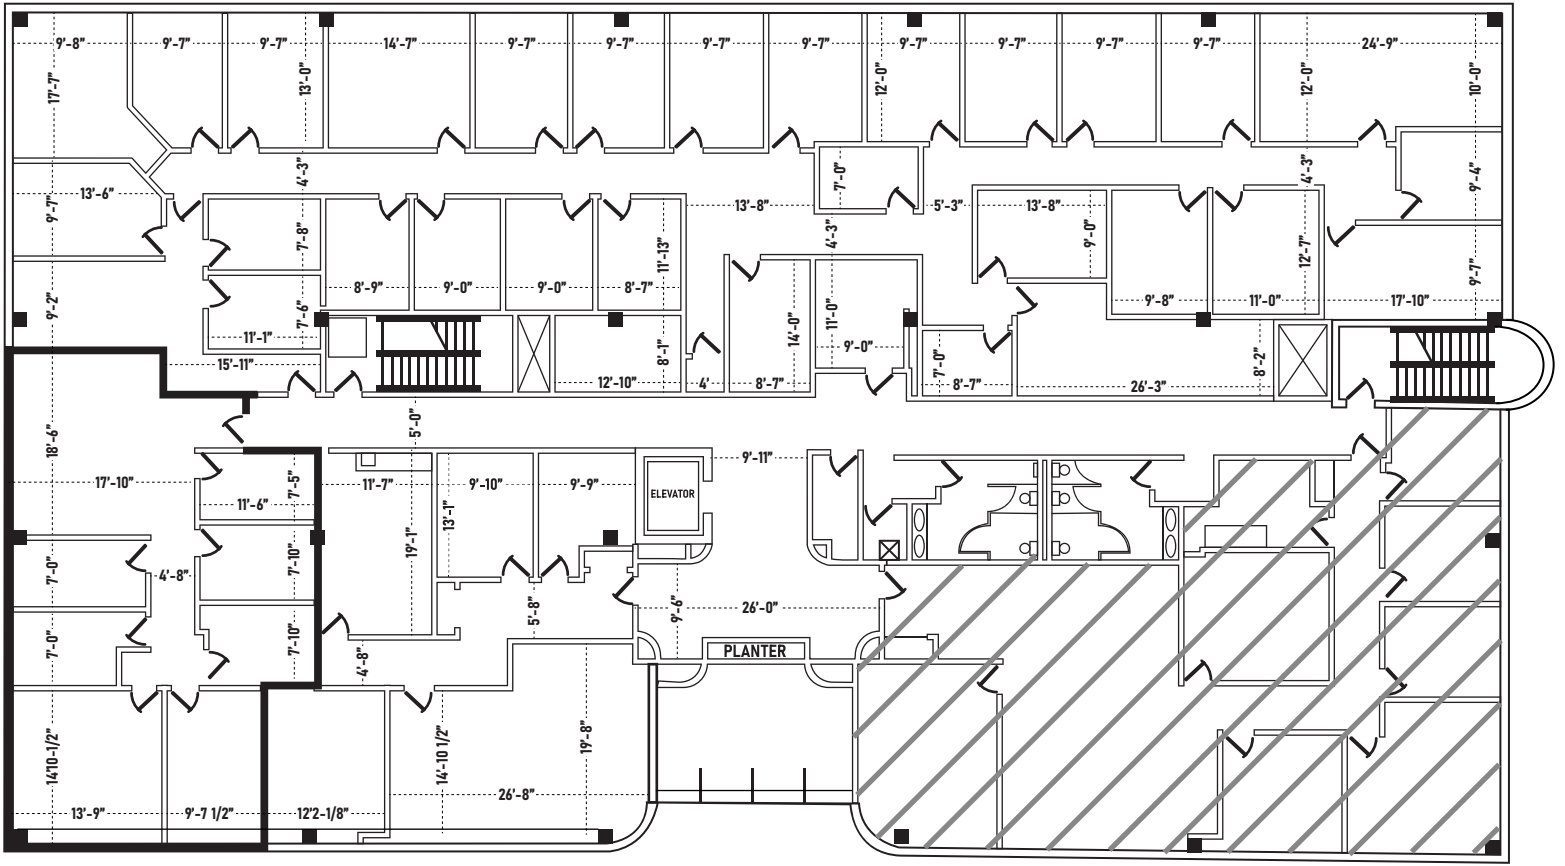

1170 THIRD FLOOR AS BUILT