

# FIRST FLOOR

## AS-BUILT DIAGRAM

101 W PONCE DE LEON AVENUE  
DECATUR, GA 30030

For leasing information, contact:


**JESSICA DOYLE**  
Senior Vice President  
+1 404 408 1264  
jessica.doyle@cbre.com

**GRAHAM LITTLE**  
Vice President  
+1 404 771 7957  
graham.little@cbre.com

**CBRE, INC.**  
+1 404 504 7900  
cbre.com/atlanta

THE  
RMR  
GROUP

CBRE

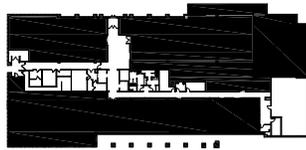

Key Plan

# 101

W. PONCE

