


EXHIBIT A - LEASED PREMISES FLOOR SPACE DIAGRAM

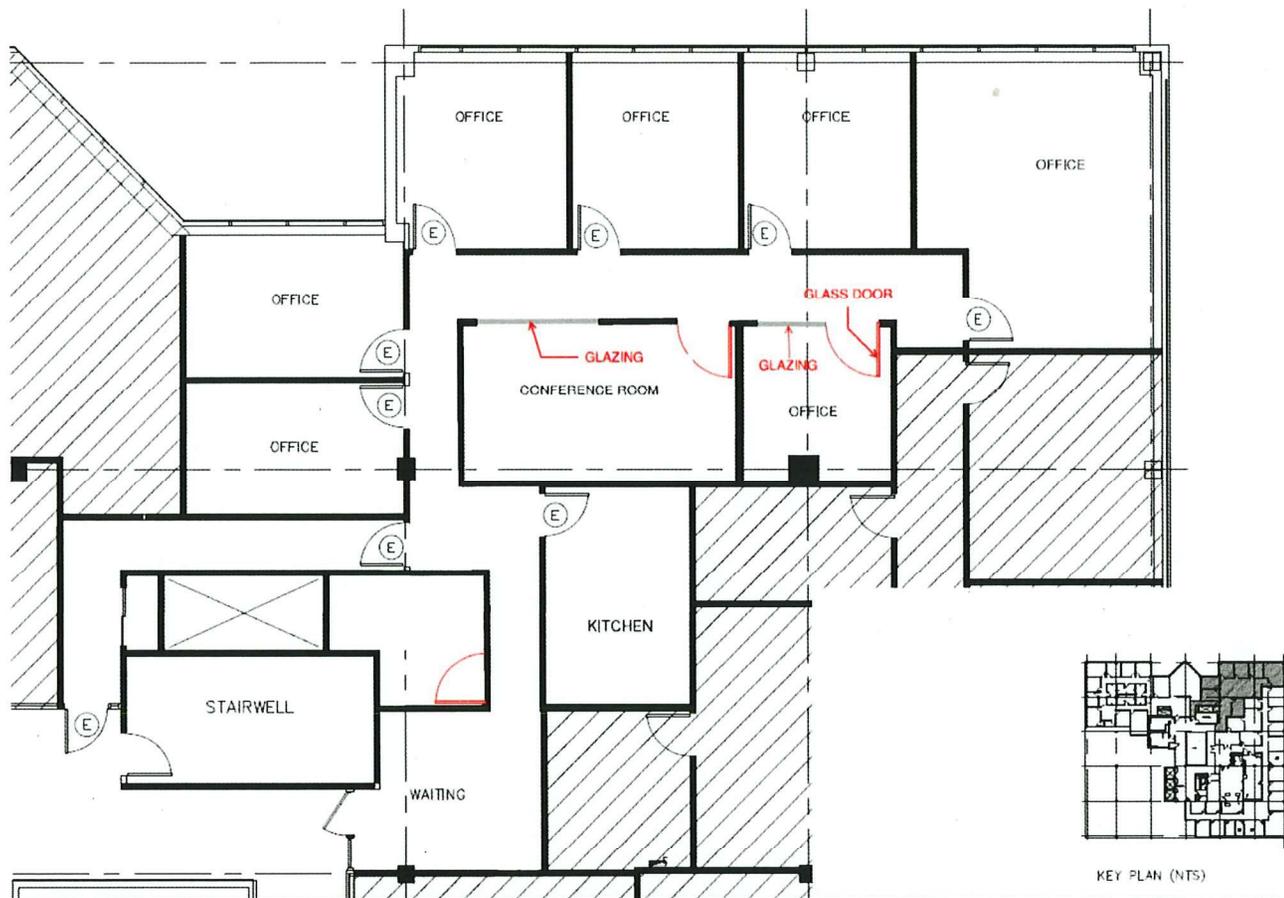

Project: **VACANT**
 285 DAVIDSON AVE FRANKLIN TWP. NEW JERSEY

Scale: NONE
 Date: 02.09.21

C. G. Albrecht A. I. A. Architect Inc.
 4 Wood Hollow Rd