


Sherwood Oaks Office Park

Building C Ste 100 6,042 sq ft

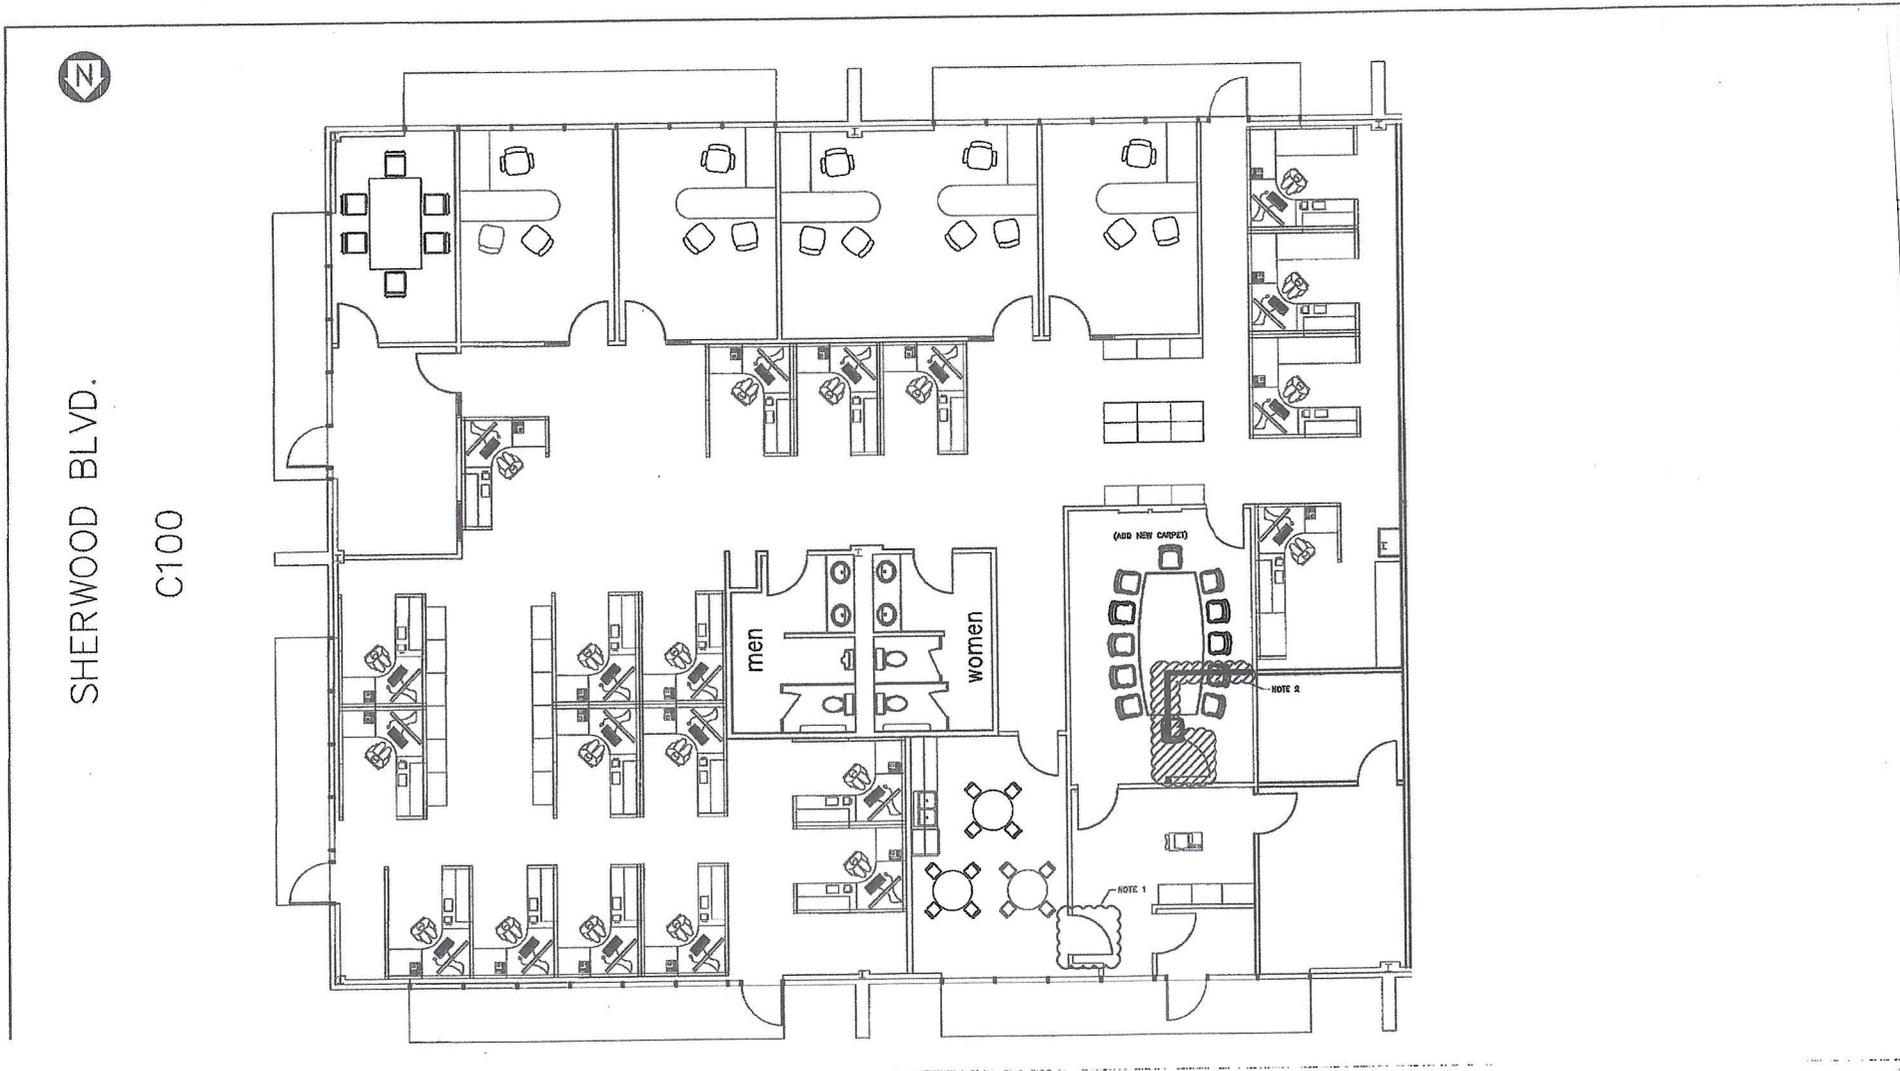

4334 S Sherwood Forest Blvd, Baton Rouge, LA 70816