


# FLOOR PLANS

## SECOND FLOOR SUITE 220 ±3,815 SF

- Open Office Area
- Market Ready
- Shared Building Locker Room with Showers

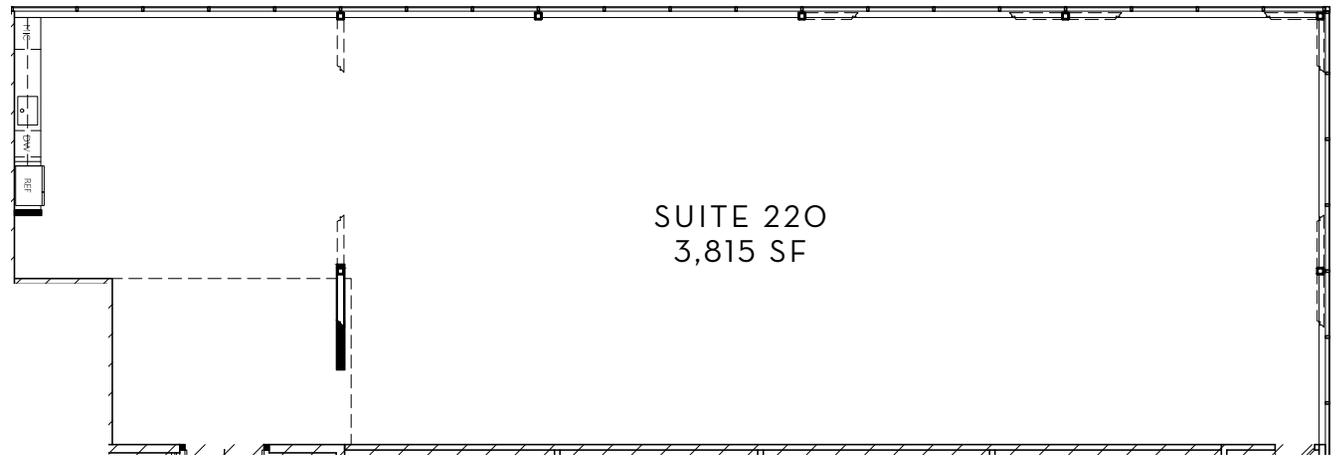

\*As Built