


PARKER ADVENTIST

ALPINE BUILDING
9397 CROWN CREST BLVD

SUITE 420
4,183 SF

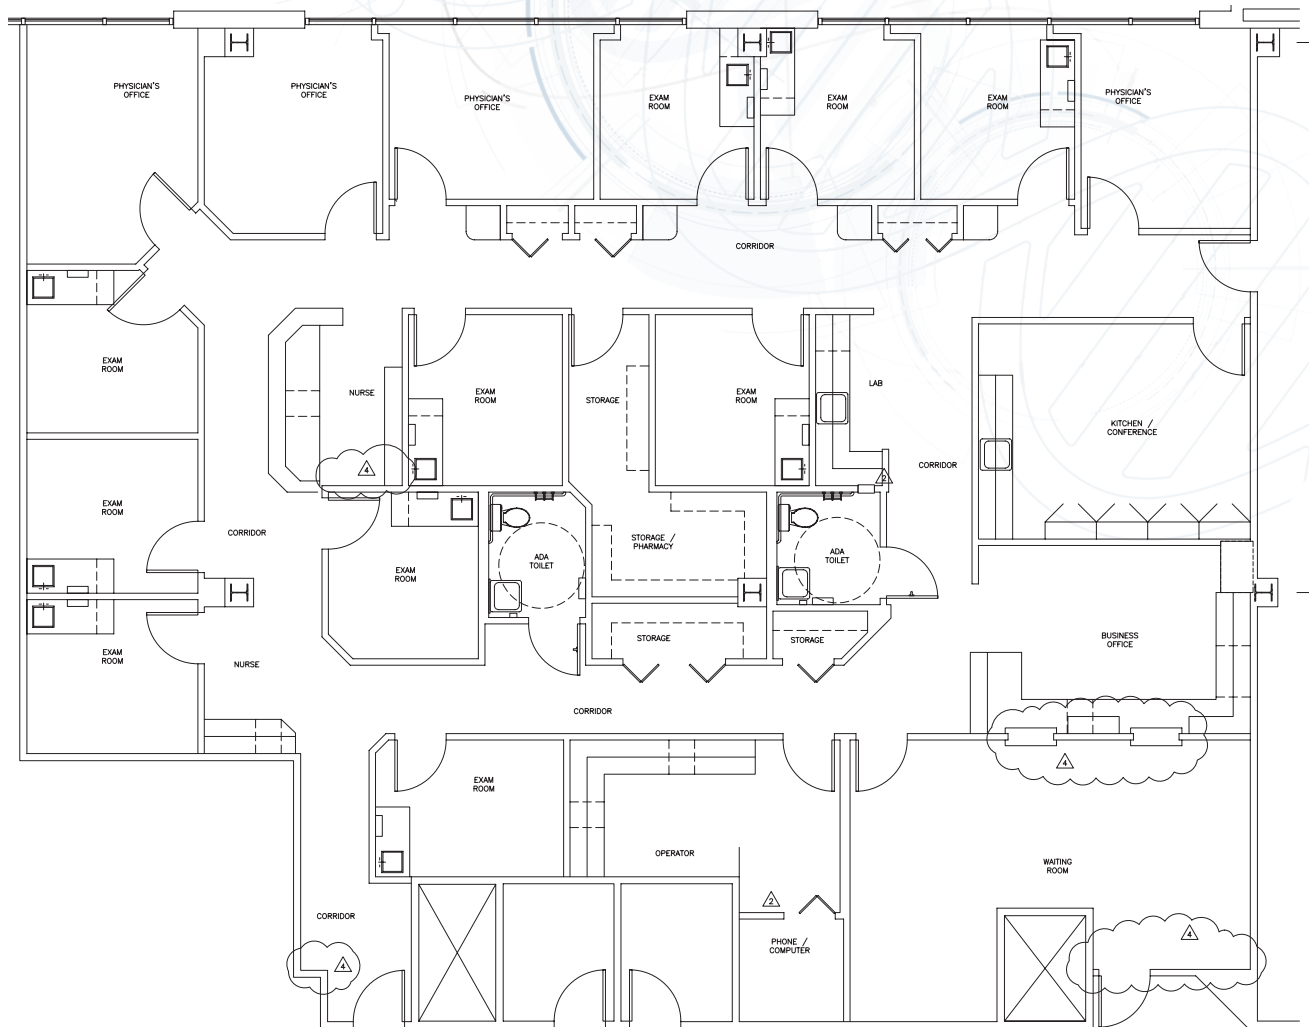

DANN BURKE | 720 528 6362 | dann.burke@cbre.com

STEPHANI GASKINS | 720 528 6346 | stephani.gaskins@cbre.com

ANNA HEISERMAN | 303 583 2099 | anna.heiserman@cbre.com



CBRE