


CONCRETE PARKING AND LOADING

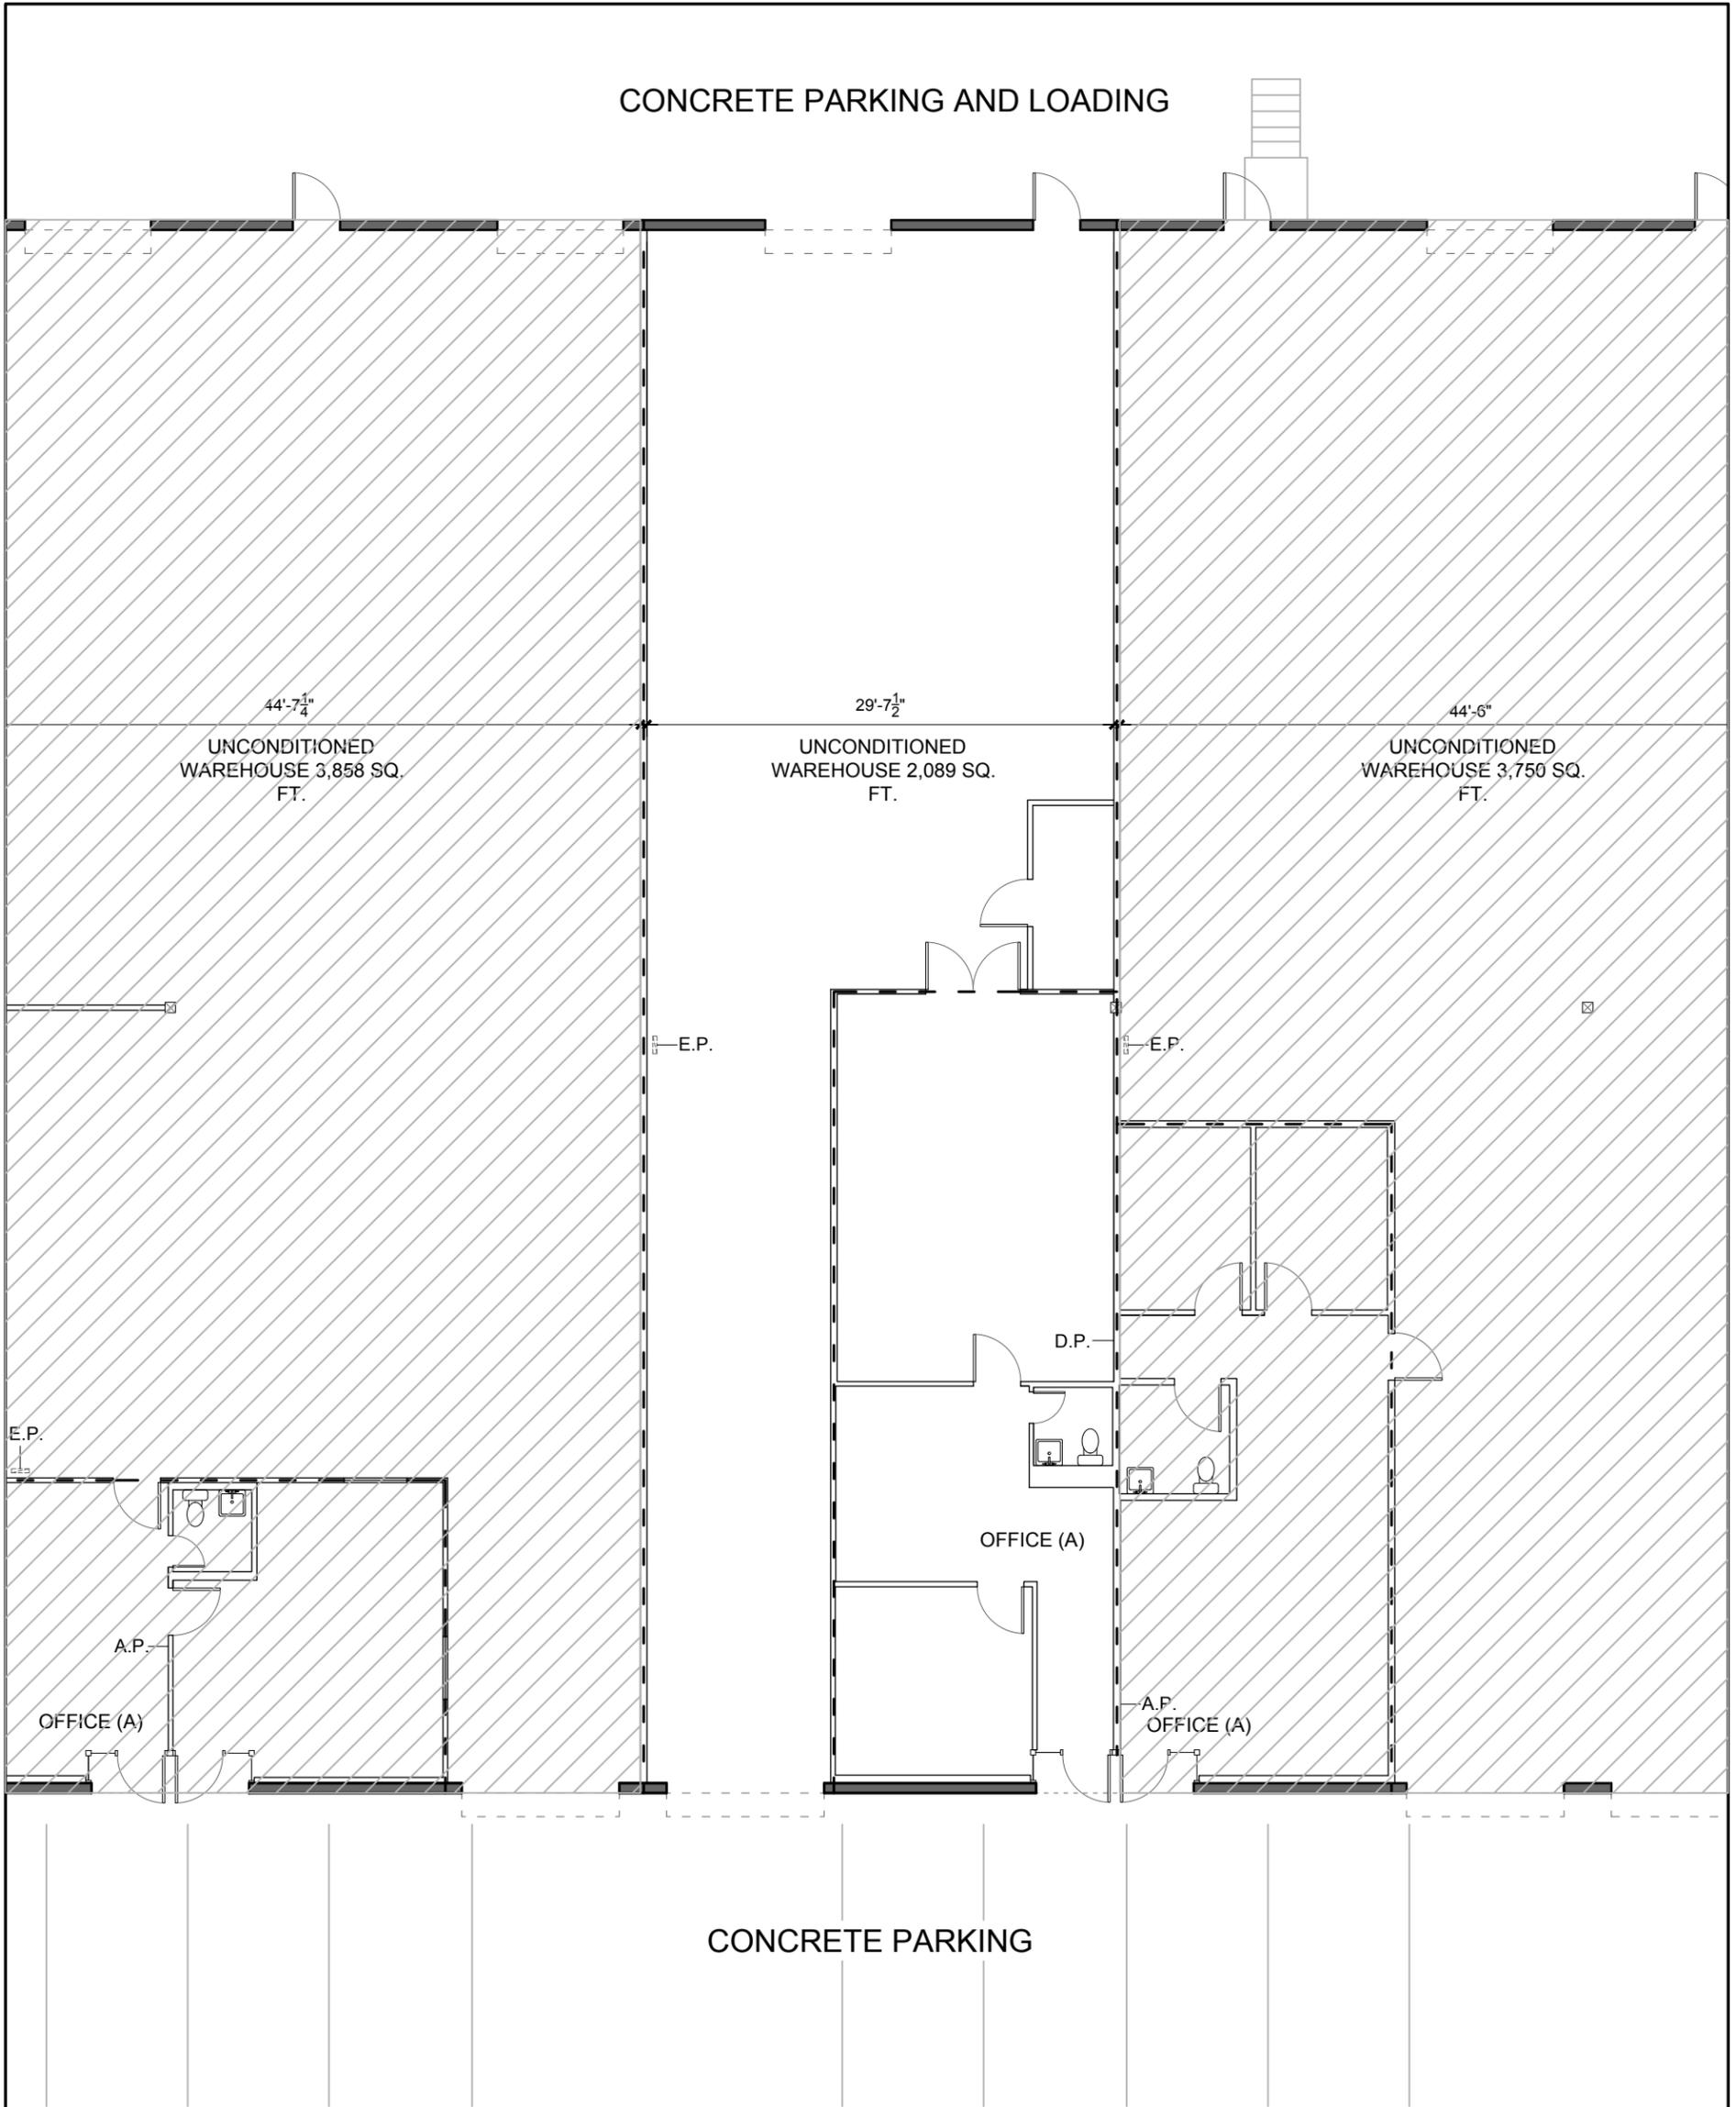

CONCRETE PARKING

SUMMARY

AREA - Bldg	SQ. FT.
LAND AREA	Not Verified
CLEAR CLG. HT. +/-	7'-10"
CONSTRUCTION	Tilt Wall
LIGHTING	Fluorescent
SLAB +/-	Not Verified

LEGEND

E.P.	Electric Panel
D.P.	Data/Telecom Panel
A.P.	Alarm Panel
N.I.	Not Included



Measuring#18-030_7402 Reindeer Trail

7402 - 7648 REINDEER TRAIL

SCALE: 3/32" = 1'-0"

DRAWN BY: MSB

DATE: FEBRUARY 25, 2019

DOCK DOOR QTY = 1

TOTAL LEASABLE AREA: 3,005 SF

FINISHED AREA: 902 SF

UNFINISHED AREA: 2,103 SF

BOMA CLASS - INDUSTRIAL - DRIP LINE METHOD

DRAWING:

#7514



BOWMAN ARCHITECTS
 4242 MEDICAL DRIVE, STE 7325
 SAN ANTONIO, TEXAS 78229
 TEL. 210.317.4377
 eMAIL matt.bowman@bowmanarchitects.com