


Key Plan



North

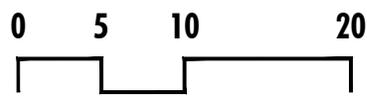

• Interior conditions have not been verified by NELSON.

CBRE

Jeff Keppen 404.504.7923

Katherine Lynch 404.504.5971

Nicole Goldsmith 404.504.7923

NELSON Concourse II • Suite 190 • 3,001 RSF

As Built