Available Suites

1528 E WILLIAMS FIELD RD

SUITE 205: ±6,403 SF[1] | $31.00 SF NNN | [1]CONTIGUOUS TO ±14,579 SF

AS-BUILT FLOOR PLAN

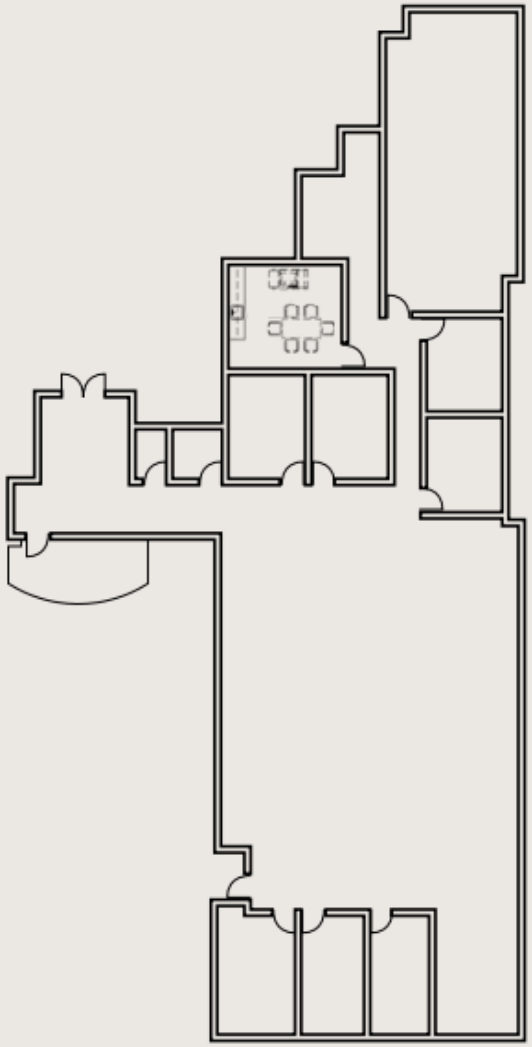

Click Here For Virtual Tour

CONCEPTUAL FLOOR PLAN

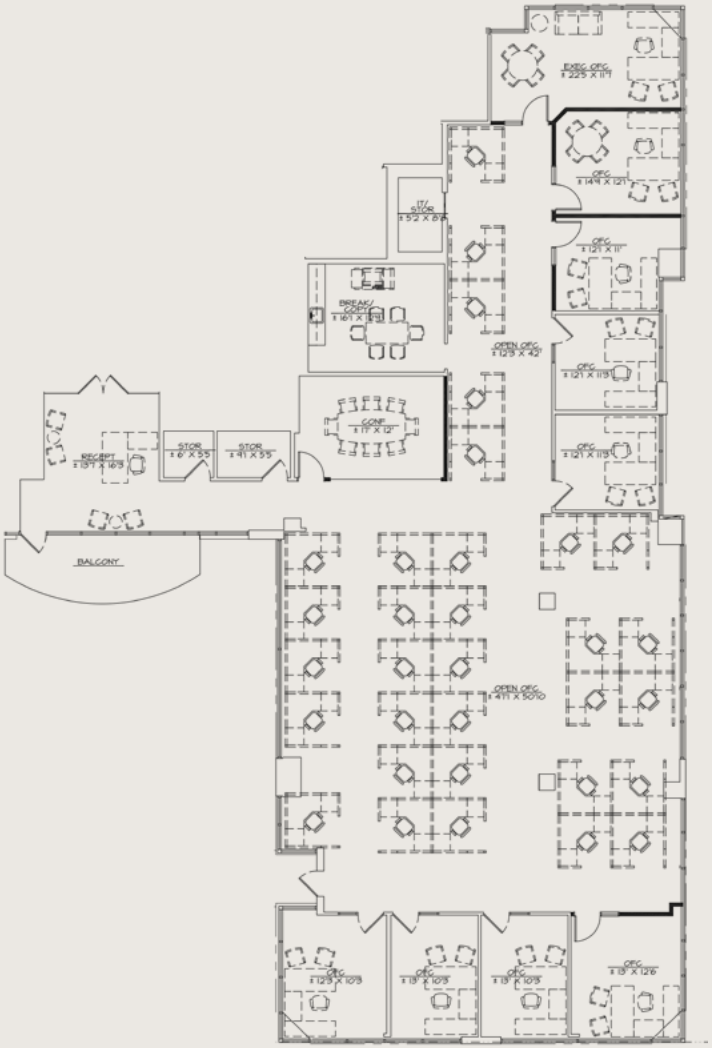

N