




SUITE 1100
AS - BUILT - 1 OF 2
615 S. COLLEGE ST.
26,710 RSF
NOT TO SCALE
DATE: JUNE 14, 2024

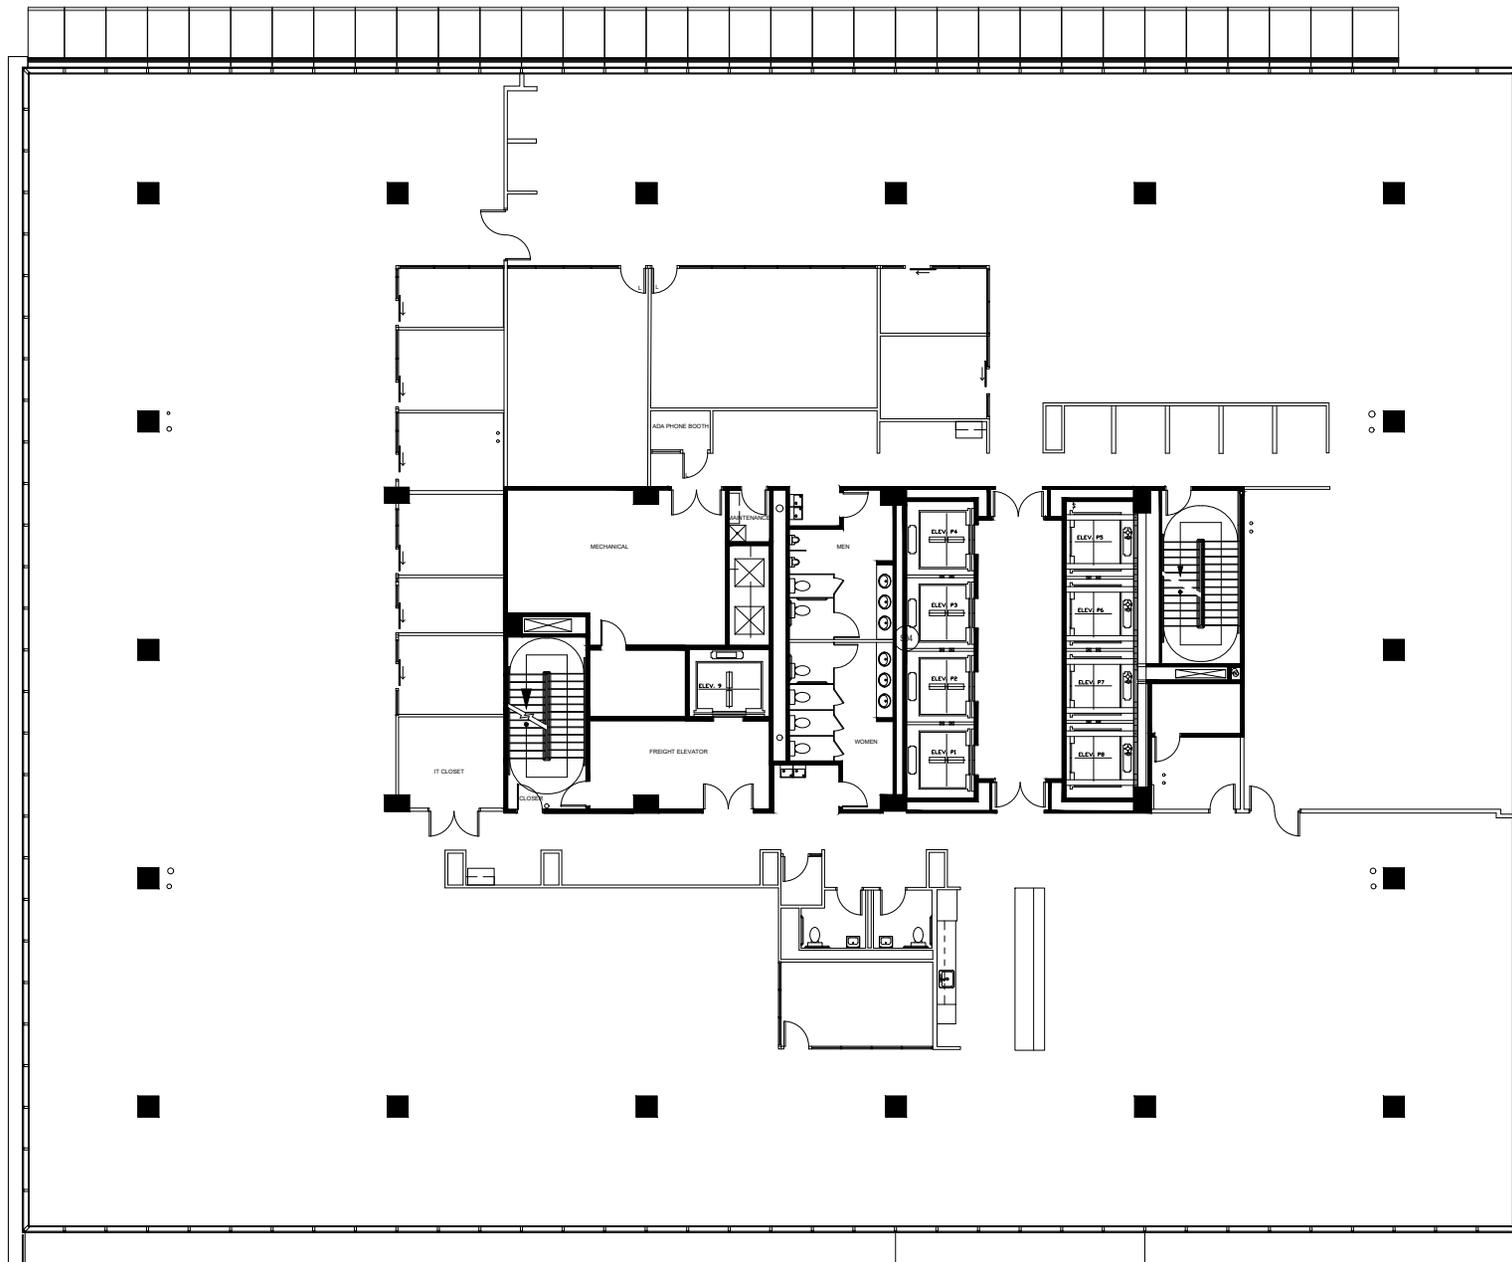

SUITE 1100
FURNITURE PLAN - 2 OF 2
615 S. COLLEGE ST.
26,710 RSF
NOT TO SCALE
DATE: JUNE 14, 2024

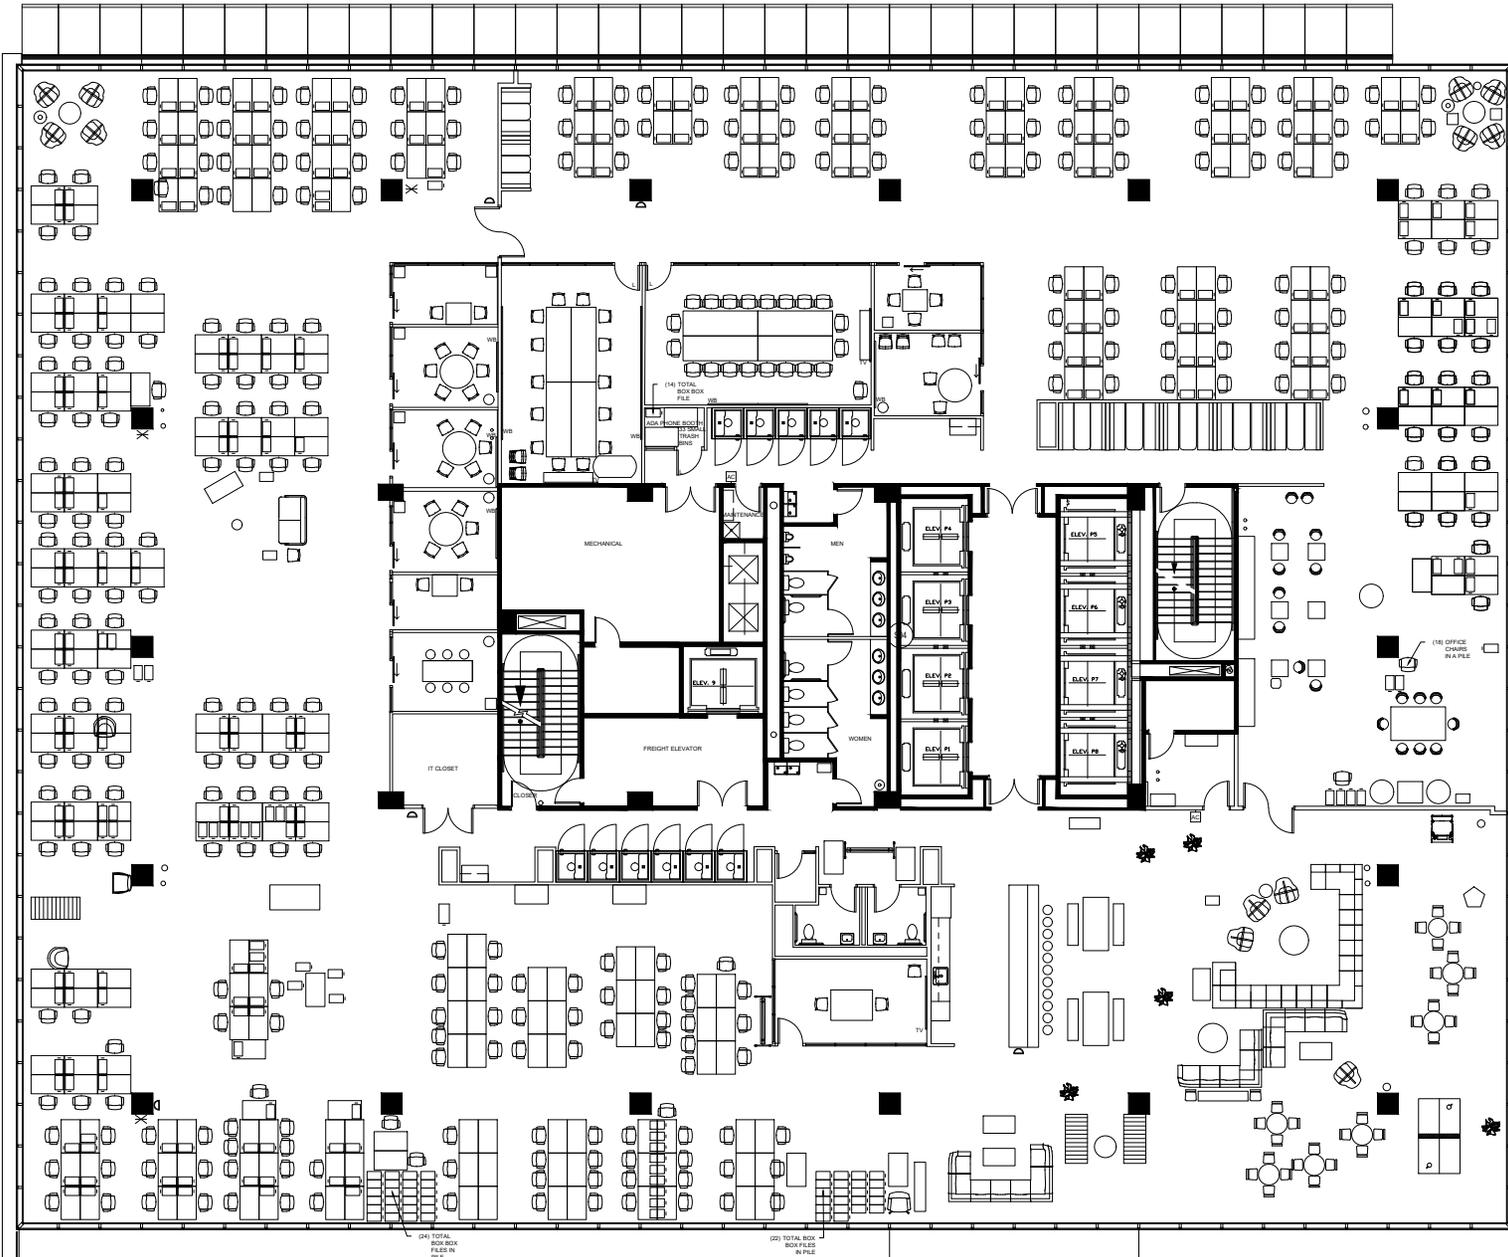

CBRE

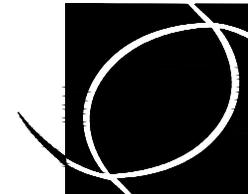

**SMITH
HARRIS
DESIGN
associates**