



SUITE 1000  
AS - BUILT - 1 OF 2  
615 S. COLLEGE ST.  
24,840 RSF  
NOT TO SCALE  
DATE: JUNE 14, 2024

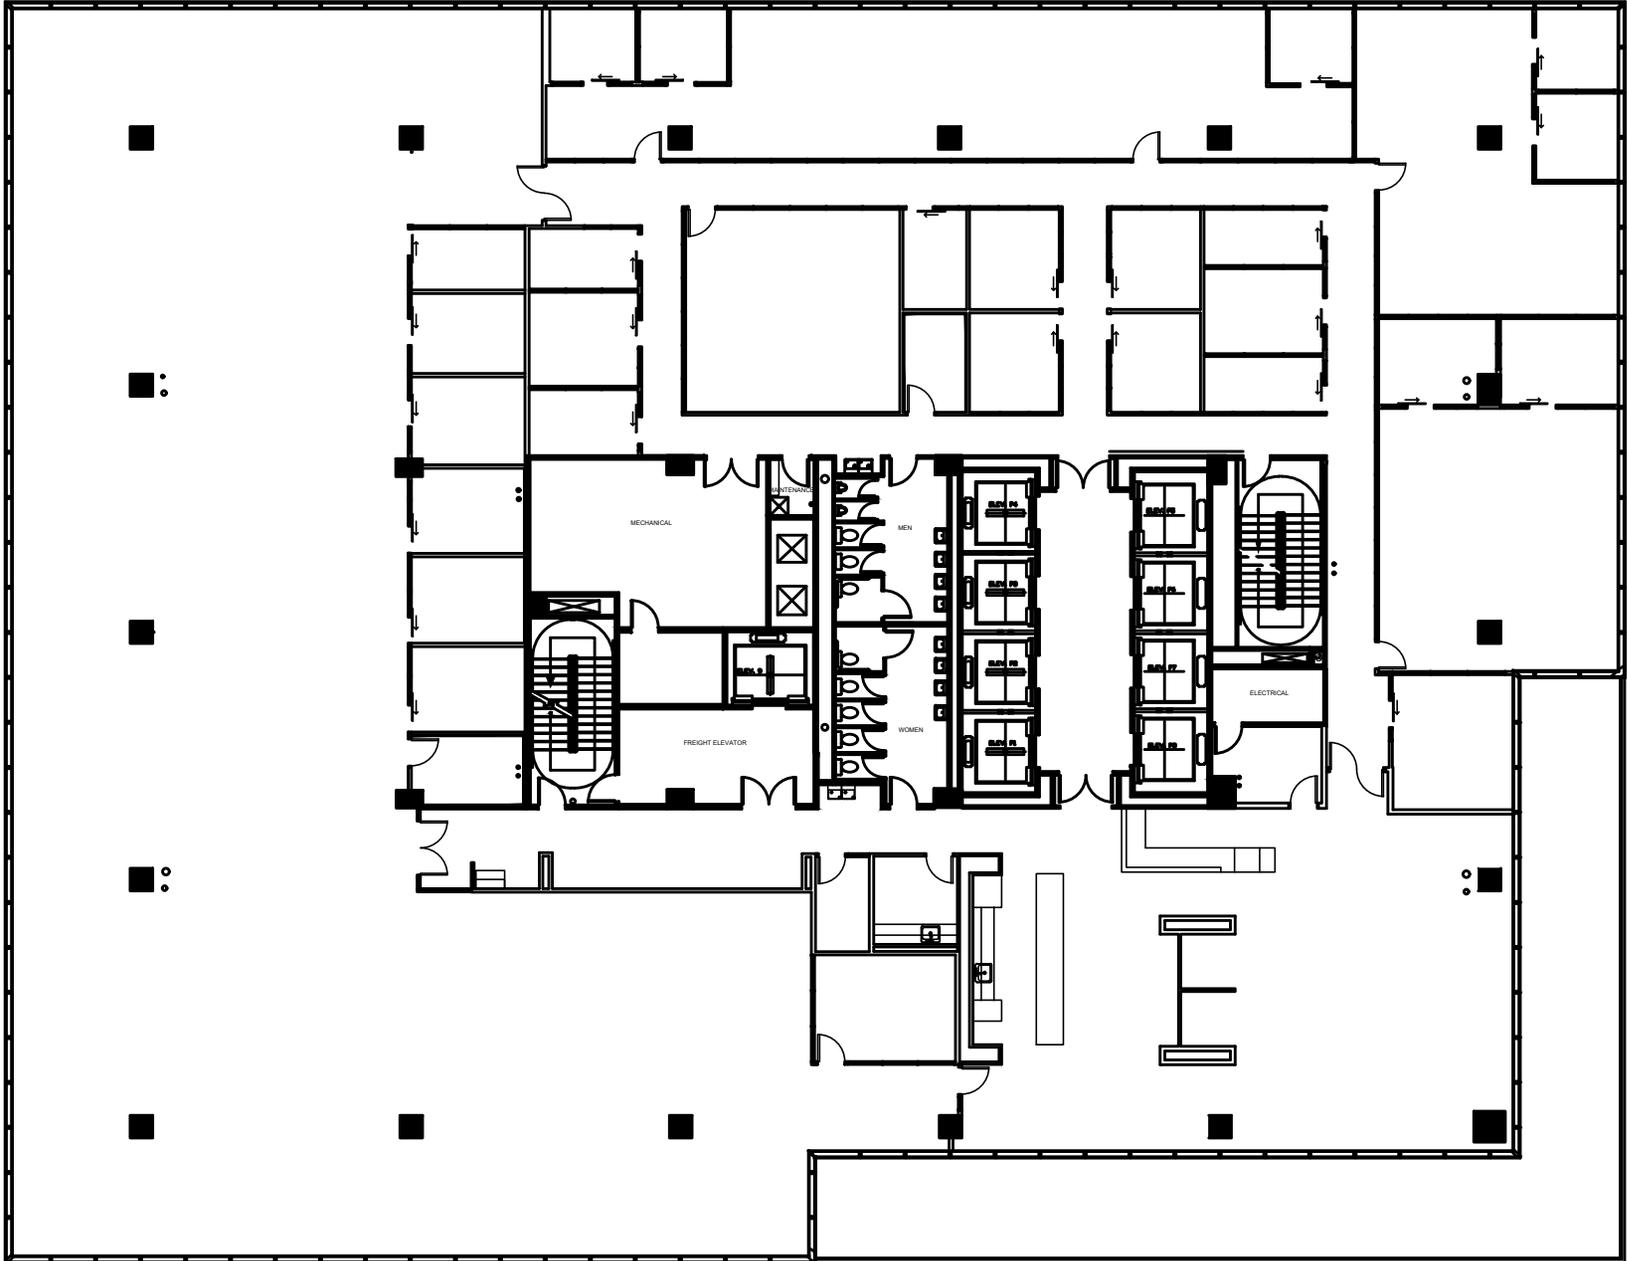

SMITH  
HARRIS  
DESIGN  
associates

SUITE 1000  
FURNITURE PLAN - 2 OF 2  
615 S. COLLEGE ST.  
24,840 RSF  
NOT TO SCALE  
DATE: JUNE 14, 2024

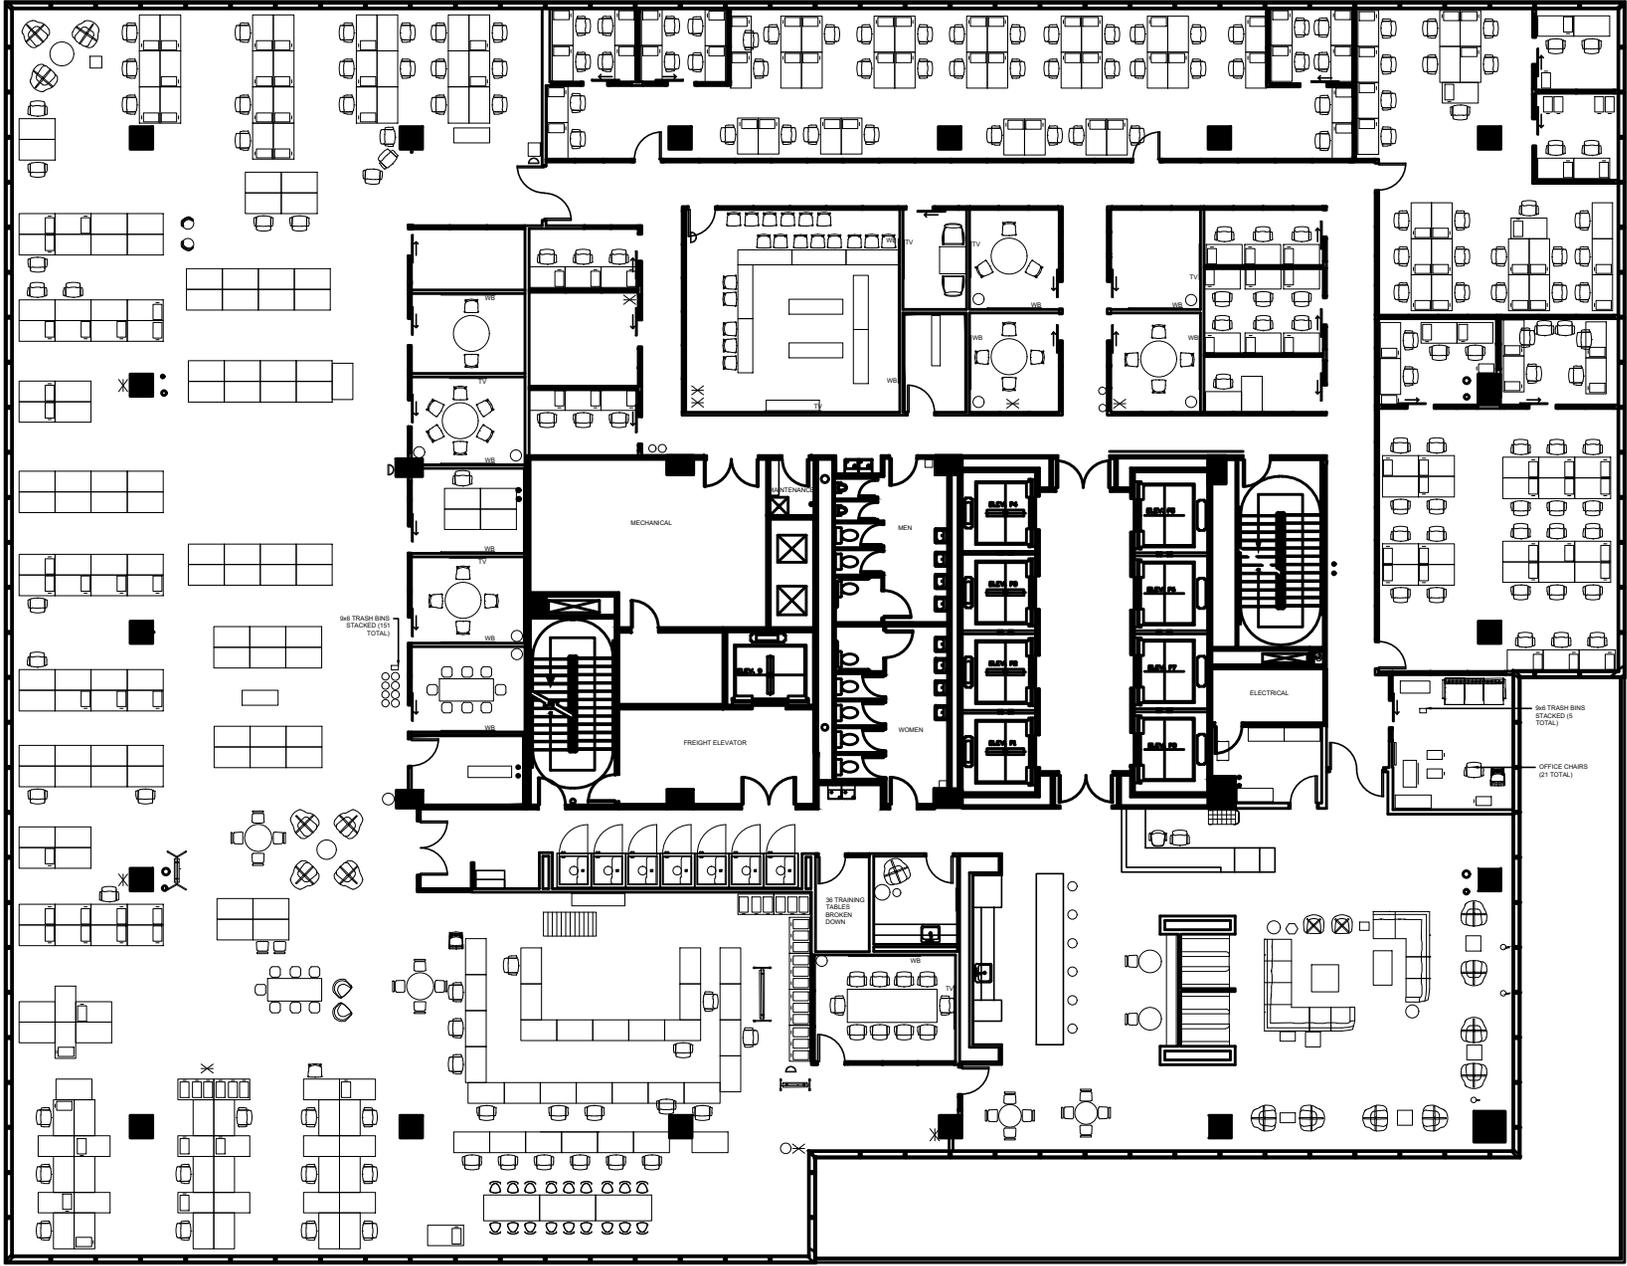

SMITH  
HARRIS  
DESIGN  
associates