

EXHIBIT A


300 Federal Street Remaining Space

LEASE EXHIBIT

FIRST FLOOR  
300 FEDERAL STREET, ANDOVER, MA  
NOVEMBER 8, 2021

Loading Dock with (2)  
Bays

Space for Lease

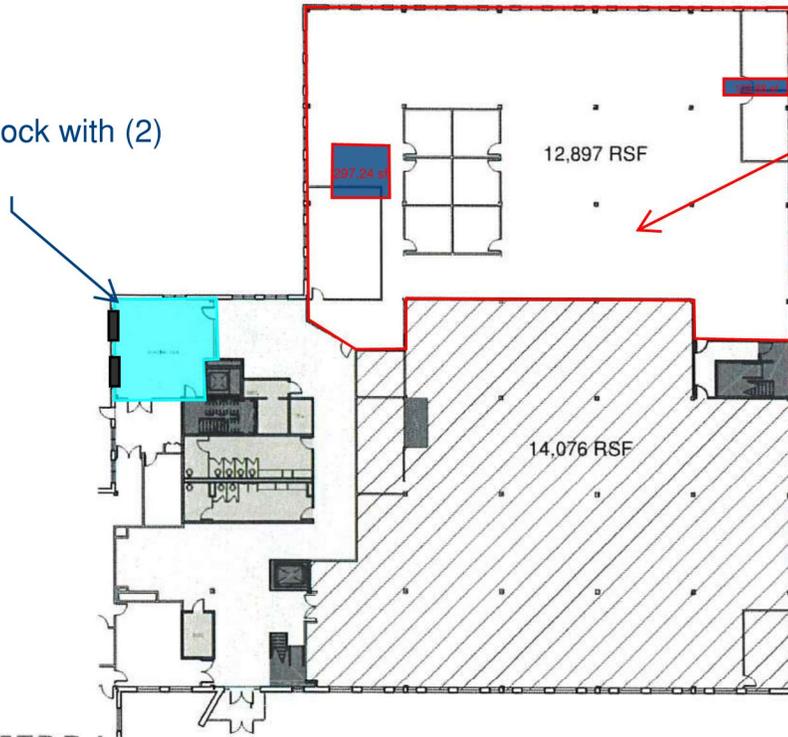

Skyworks Additional Premises

