


# Katy MOB I

705 S Fry Rd  
Katy, TX 77450  
www.cbre.com/properties

Suite 100 - 3,633 RSF

Available 3/1/2026

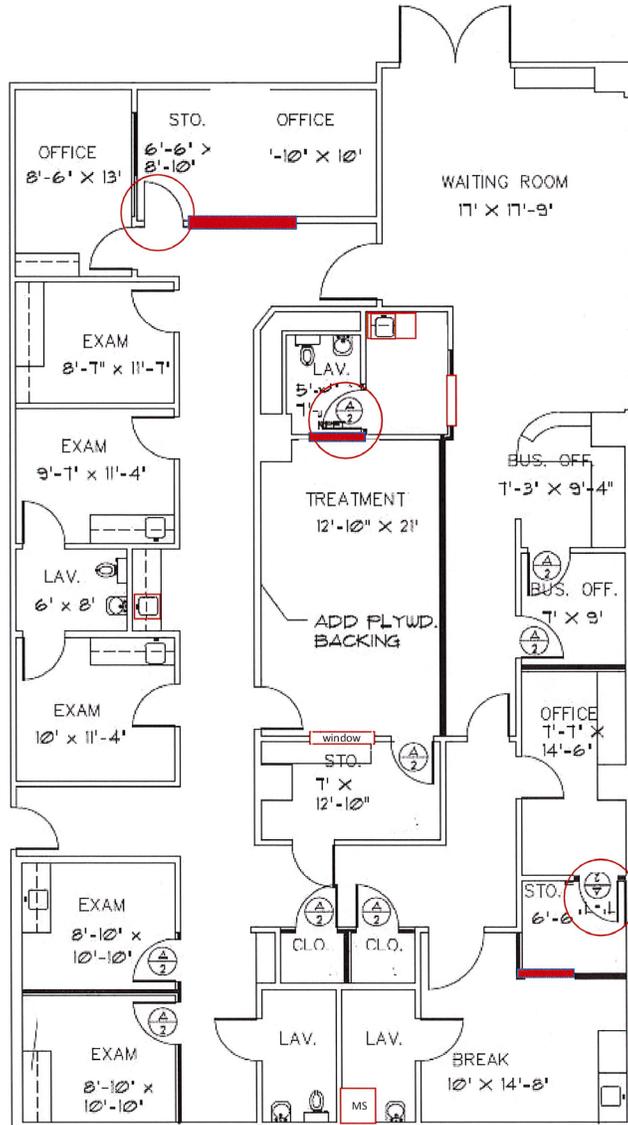

## Contact Us

**Lane Kane**  
Senior Associate  
+1 904 305 7633  
lane.kane@cbre.com

**Angela Barber**  
Vice President  
+1 832 455 6945  
angela.barber@cbre.com

**Brandy Bellow Spinks**  
Executive Vice President  
+1 713 726 6100  
brandy.bellow@cbre.com



1st Floor